

CARD MUST BE TYPED

State of Kansas
NOTICE OF INTENTION TO DRILL
(see rules on reverse side)

CARD MUST BE SIGNED

Starting Date: August 31, 1985
month day year

API Number 15-

141-20,220-00-00

OPERATOR: License # 5134
Name Graham-Michaelis Corporation
Address P. O. Box 247
City/State/Zip Wichita, Kansas 67201
Contact Person Jack L. Yinger
Phone (316) 264-8394

SW NE SE Sec 32 Twp 8S S, Rge 15
(location) East West

1650 Ft North from Southeast Corner of Section
990 Ft West from Southeast Corner of Section
(Note: Locate well on Section Plat on reverse side)

CONTRACTOR: License # 5302
Name Red Tiger Drilling Company
City/State Wichita, Kansas

Nearest lease or unit boundary line 330 feet.
County Osborne
Lease Name Hofstetter Well# 2-32

Well Drilled For: Well Class: Type Equipment:
 Oil Swd Infield Mud Rotary
 Gas Inj Pool Ext. Air Rotary
 OWWO Expl Wildcat Cable

Domestic well within 330 feet: yes no
Municipal well within one mile: yes no

If OWWO: old well info as follows:

Operator
Well Name
Comp Date Old Total Depth
Projected Total Depth 3550 feet
Projected Formation at TD Lansing-K.C.
Expected Producing Formations Lansing-K.C.

Depth to Bottom of fresh water ~ 100 feet
Lowest usable water formation DAKOTA
Depth to Bottom of usable water ~ 850 feet
Surface pipe by Alternate: 1 2
Surface pipe to be set Approx. 225 feet
Conductor pipe if any required 1993' feet
Ground surface elevation 1993' feet MSL
This Authorization Expires 2-21-86
Approved By RCH 8-21-85


I certify that we will comply with K.S.A. 55-101, et seq., plus eventually plugging hole to K.C.C. specifications.

Date 8-20-85 Signature of Operator or Agent Jack L. Yinger Title Vice President
Form C-1 4/84

**Must be filed with the K.C.C. five (5) days prior to commencing well
This card void if drilling not started within six (6) months of date received by K.C.C.**

Important procedures to follow:

**A Regular Section of Land
1 Mile = 5,280 Ft.**

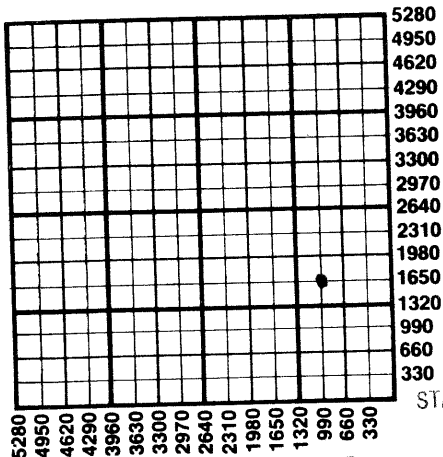

8-21-85

1. Notify District office before setting surface casing.
2. Set surface casing by circulating cement to the top.
3. File completion forms ACO-1 with K.C.C. within 90 days of well completion, following instructions on ACO-1, side 1, and including copies of wireline logs.
4. Notify District office 48 hours prior to old well workover or re-entry.
5. Prior to plugging, prepare a plugging plan, then obtain agreement from the appropriate district office for an approved plugging plan.
6. Submit plugging report (CP-4) to K.C.C. after plugging is completed.
7. Obtain an approved injection docket number before disposing of salt water.
8. Notify K.C.C. within 10 days when injection commences or terminates.

9. If an alternate 2 completion, cement in the production pipe from below any usable water to surface within 120 days of spud date.

RECEIVED
STATE CORPORATION COMMISSION

AUG 21 1985

CONSERVATION DIVISION
Wichita, Kansas

State Corporation Commission of Kansas
Conservation Division
200 Colorado Derby Building
Wichita, Kansas 67202
(316) 263-3238