

CARD MUST BE TYPED

State of Kansas

CARD MUST BE SIGNED

### NOTICE OF INTENTION TO DRILL

(see rules on reverse side)

Starting Date ... February ... 12, 1987 ...  
month day year

API Number 15- 065-22,352-5000

OPERATOR: License # 6111  
Name N-B. Company, Inc.  
Address P. O. Box 506  
City/State/Zip Russell, KS 67665-0506  
Contact Person Kyle B. Branum  
Phone (913)-483-5345

...C. NE... Sec. 35... Twp. 7... S, Rg. 23... X West  
3960 Ft. from South Line of Section  
1320 Ft. from East Line of Section

(Note: Locate well on Section Plat on reverse side)

CONTRACTOR: License # 8241  
Name Emphasis Oil Operations  
City/State P. O. Box 506, Russell, KS 67665-0506

Nearest lease or unit boundary line 1320 feet  
County Graham

Lease Name Wanker Well # 2

Ground surface elevation 2300 Est. feet MSL

Well Drilled For: Well Class: Type Equipment:  
X Oil SWD X Infield X Mud Rotary  
Gas Inj Pool Ext. Air Rotary  
OWWO Expl Wildcat Cable

Domestic well within 330 feet: yes X no

Municipal well within one mile: yes X no

Depth to bottom of fresh water 200

Depth to bottom of usable water 1100

Surface pipe by Alternate: 1 2 X

Surface pipe planned to be set 240'

Conductor pipe required N/A

Projected Total Depth 3800 feet

Formation Kansas City

If OWWO: old well info as follows:

Operator  
Well Name  
Comp Date Old Total Depth

I certify that well will comply with K.S.A. 55-101, et seq., plus eventually plugging hole to KCC specifications.

Date 1-26-87 Signature of Operator or Agent

Title President

For KCC Use:

Conductor Pipe Required feet; Minimum Surface Pipe Required 200 feet per Alt. 40

This Authorization Expires 7-28-87 Approved By 1/28/87


*[Handwritten signature]*

Must be filed with the K.C.C. five (5) days prior to commencing well  
 This card void if drilling not started within six (6) months of date received by K.C.C.

**Important procedures to follow:**

1. Notify District office before setting surface casing.
2. Set surface casing by circulating cement to the top.
3. File completion forms ACO-1 with K.C.C. within 90 days of well completion, following instructions on ACO-1, side 1, and including copies of wireline logs.
4. Notify District office 48 hours prior to old well workover or re-entry.
5. Prior to filing Intent, prepare a proposed plugging plan in case well is D & A, then obtain approval of plan when calling district office prior to setting surface pipe.
6. Submit plugging report (CP-4) to K.C.C. after plugging is completed.
7. Obtain an approved injection docket number before disposing of salt water.
8. Notify K.C.C. within 10 days when injection commences or terminates.
9. If an alternate 2 completion, cement in the production pipe from below any usable water to surface within 120 days of spud date.

**A Regular Section of Land**  
 1 Mile = 5,280 Ft.

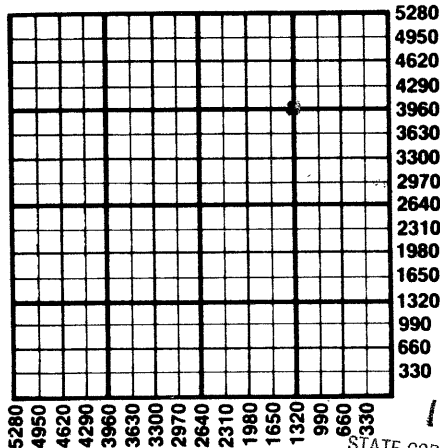

1/28/87

STATE CORPORATION COMMISSION

JAN 28 1987

CONSERVATION DIVISION  
 Wichita, Kansas

State Corporation Commission of Kansas  
 Conservation Division  
 200 Colorado Derby Building  
 Wichita, Kansas 67202  
 (316) 263-3238