

CARD MUST BE TYPED

State of Kansas

CARD MUST BE SIGNED

NOTICE OF INTENTION TO DRILL

(see rules on reverse side)

Starting Date ... September 23, 1986
month day year

API Number 15- 065-22,324-0-00
120' E & 100' S of

OPERATOR: License # 6177

NW/C NW NW NW Sec. 35 Twp. 7 S, Rg. 23 East West

Name ... Foxfire Exploration, Inc.

5180 Ft. from South Line of Section

Address ... 1022 Union Center

5160 Ft. from East Line of Section

City/State/Zip ... Wichita, Kansas 67202

(Note: Locate well on Section Plat on reverse side)

Contact Person ... D.C. Marchant/Maxine Starr

Nearest lease or unit boundary line ... 100 feet

Phone ... (915) 682-8952 / (316) 265-6296

County ... Graham

CONTRACTOR: License # 8430

Lease Name ... Korb Well # ... 2 SWDW

Name ... Foxfile Drilling Co. Inc.

Ground surface elevation ... 2,345 EST. feet MSL

City/State ... Box 133, Wakeeney, Kansas 67672

Domestic well within 330 feet: yes no

Well Drilled For: Well Class: Type Equipment:

Municipal well within one mile: yes no

Oil SWD Infield Mud Rotary

Depth to bottom of fresh water ... 75'

Gas Inj Pool Ext. Air Rotary

Depth to bottom of usable water ... 1100'

OWWO Expl Wildcat Cable

Surface pipe by Alternate: 1 2

If OWWO: old well info as follows:

Surface pipe planned to be set ... 285'

Operator

Conductor pipe required ... NONE

Well Name

Projected Total Depth ... 3750 feet

Comp Date

Formation ... Lansing

I certify that well will comply with K.S.A. 55-101, et seq., plus eventually plugging hole to KCC specifications.

Date 9/15/86 Signature of Operator or Agent [Signature]

Title PRESIDENT

For KCC Use: Conductor Pipe Required ... feet; Minimum Surface Pipe Required ... 285 feet per Alt. [Signature]

This Authorization Expires ... 3-17-87 Approved By ... 9-17-86 [Signature]


WILL SET PORT COLLAR IN ANHYDRITE AND CEMENT UPPER STAGE DURING COMPLETION.

Must be filed with the K.C.C. five (5) days prior to commencing well
 This card void if drilling not started within six (6) months of date received by K.C.C.

Important procedures to follow:

1. Notify District office before setting surface casing.
2. Set surface casing by circulating cement to the top.
3. File completion forms ACO-1 with K.C.C. within 90 days of well completion, following instructions on ACO-1, side 1, and including copies of wireline logs.
4. Notify District office 48 hours prior to old well workover or re-entry.
5. Prior to filing Intent, prepare a proposed plugging plan in case well is D & A, then obtain approval of plan when calling district office prior to setting surface pipe.
6. Submit plugging report (CP-4) to K.C.C. after plugging is completed.
7. Obtain an approved injection docket number before disposing of salt water.
8. Notify K.C.C. within 10 days when injection commences or terminates.

A Regular Section of Land
1 Mile = 5,280 Ft.

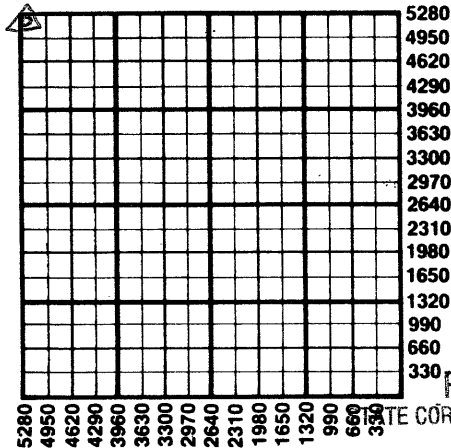

RECEIVED

STATE CORPORATION COMMISSION

SEP 17 1986
 9/17/86
 CONSERVATION DIVISION
 Wichita, Kansas

9. If an alternate 2 completion, cement in the production pipe from below any usable water to surface within 120 days of spud date.

State Corporation Commission of Kansas
 Conservation Division
 200 Colorado Derby Building
 Wichita, Kansas 67202
 (316) 263-3238