

CARD MUST BE TYPED

State of Kansas

CARD MUST BE SIGNED ✓

NOTICE OF INTENTION TO DRILL

(see rules on reverse side)

Starting Date SEPTEMBER 12 1987
month day year

API Number 15— 065-22,406 0000

OPERATOR: License # 5923
Name AMERICAN PETROLEUM COMPANY, INC.
Address 3500 NORTH ROCK ROAD, BLDG. #1300
City/State/Zip WICHITA, KANSAS 67226
Contact Person JAMES BARVAIS
Phone (316) 684-5273

SW SE SW Sec. 16 Twp. 7 S, Rg. 23 XX East West
330 Ft. from South Line of Section
3630 Ft. from East Line of Section

(Note: Locate well on Section Plat on reverse side)

CONTRACTOR: License # 8241
Name EMPHASIS OIL OPERATIONS
City/State RUSSELL, KANSAS 67665

Nearest lease or unit boundary line 330 feet
County GRAHAM
Lease Name BRANT Well # 1

Well Drilled For: Well Class: Type Equipment:
 Oil SWD Infield Mud Rotary
 Gas Inj Pool Ext. Air Rotary
 OWWO Expl Wildcat Cable

Ground surface elevation 2360 feet MSL
Domestic well within 330 feet: yes no
Municipal well within one mile: yes no

If OWWO: old well info as follows:
Operator
Well Name
Comp Date Old Total Depth

Depth to bottom of fresh water 75
Depth to bottom of usable water 1100
Surface pipe by Alternate: 1 2 XX
Surface pipe planned to be set 200
Conductor pipe required NONE
Projected Total Depth 3900 feet
Formation LANSING-KC

I certify that well will comply with K.S.A. 55-101, et seq. plus eventually plugging hole to KCC specifications.
Date 9-11-87 Signature of Operator or Agent [Signature] Title PRESIDENT


For KCC Use:
Conductor Pipe Required feet; Minimum Surface Pipe Required 200 feet per Alt. X(2)
This Authorization Expires 3-11-89 Approved By [Signature] 9-11-87
Effective 9-16-87

Must be filed with the K.C.C. five (5) days prior to commencing well
This card void if drilling not started within six (6) months of date received by K.C.C.

Important procedures to follow:

1. Notify District office before setting surface casing.
2. Set surface casing by circulating cement to the top.
3. File completion forms ACO-1 with K.C.C. within 90 days of well completion, following instructions on ACO-1, side 1, and including copies of wireline logs.
4. Notify District office 48 hours prior to old well workover or re-entry.
5. Prior to filing Intent, prepare a proposed plugging plan in case well is D & A, then obtain approval of plan when calling district office prior to setting surface pipe.
6. Submit plugging report (CP-4) to K. C. C. after plugging is completed.
7. Obtain an approved injection docket number before disposing of salt water.
8. Notify K.C.C. within 10 days when injection commences or terminates.
9. If an alternate 2 completion, cement in the production pipe from below any usable water to surface within 120 days of spud date.

**A Regular Section of Land
1 Mile = 5,280 Ft.**

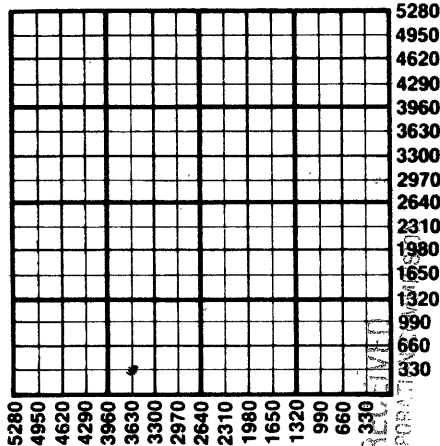

STATE CORPORATION COMMISSION
RECEIVED
SEP 11 1987
7/11/87
CONSERVATION DIVISION
Wichita, Kansas

State Corporation Commission of Kansas
Conservation Division
200 Colorado Derby Building
Wichita, Kansas 67202
(316) 263-3238