

CARD MUST BE TYPED

State of Kansas  
NOTICE OF INTENTION TO DRILL  
(see rules on reverse side)

CARD MUST BE SIGNED

Starting Date: 3-4-85  
month day year 9:26

OPERATOR: License # 6177  
Name Foxfire Exploration, Inc.  
Address P. O. Drawer 6360  
City/State/Zip Los Osos, California 93402  
Contact Person D. C. Marchant  
Phone 805-528-6008

CONTRACTOR: License # 8430  
Name Foxfire Drilling Co.  
City/State WaKeeney, Kansas

Well Drilled For: Well Class: Type Equipment:  
 Oil  Swd  Infield  Mud Rotary  
 Gas  Inj  Pool Ext.  Air Rotary  
 OWWO  Expl  Wildcat  Cable

If OWWO: old well info as follows:

Operator  
Well Name  
Comp Date Old Total Depth  
Projected Total Depth 3800 feet  
Projected Formation at TD Marmaton  
Expected Producing Formations Lansing-Kansas City

API Number 15- 065-22,153-00-00  
150' N. of  
C SW NE NW Sec 35 Twp 7S S, Rge 23W  East  
(location)  West

4440 Ft North from Southeast Corner of Section  
3630 Ft West from Southeast Corner of Section  
(Note: Locate well on Section Plat on reverse side)

Nearest lease or unit boundary line 480 feet.  
County Graham  
Lease Name Korb Well# 2  
Domestic well within 330 feet:  yes  no  
Municipal well within one mile:  yes  no

Depth to Bottom of fresh water 120 feet  
Lowest usable water formation Dakota  
Depth to Bottom of usable water 1100 feet  
Surface pipe by Alternate: 1  2   
Surface pipe to be set 280 feet  
Conductor pipe if any required No feet  
Ground surface elevation 2294 feet MSL  
This Authorization Expires 3-4-85  
Approved By 3-4-85 [Signature]

I certify that we will comply with K.S.A. 55-101, et seq., plus eventually plugging hole to K.C.C. specifications.

Date 3-4-85 Signature of Operator or Agent [Signature] Title Land Manager

MHC/MOHE 3-4-85

Must be filed with the K.C.C. five (5) days prior to commencing well  
 This card void if drilling not started within six (6) months of date received by K.C.C.


Wichita, Kansas

CONSERVATION DIVISION

MAR 4 1985

3/4/85

STATE CORPORATION COMMISSION OF KANSAS  
 A Regular Section of Land  
 1 Mile / 3,280 Ft.

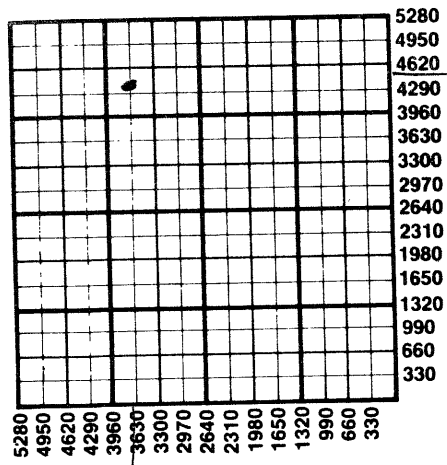

**Important procedures to follow :**

1. Notify District office before setting surface casing.
2. Set surface casing by circulating cement to the top.
3. File completion forms ACO-1 with K.C.C. within 90 days of well completion, following instructions on ACO-1, side 1, and including copies of wireline logs.
4. Notify District office 48 hours prior to old well workover or re-entry.
5. Prior to plugging, prepare a plugging plan, then obtain agreement from the appropriate district office for an approved plugging plan.
6. Submit plugging report (CP-4) to K.C.C. after plugging is completed.
7. Obtain an approved injection docket number before disposing of salt water.
8. Notify K.C.C. within 10 days when injection commences or terminates.
9. If an alternate 2 completion, cement in the production pipe from below any usable water to surface within 120 days of spud date.

State Corporation Commission of Kansas  
 Conservation Division  
 200 Colorado Derby Building  
 Wichita, Kansas 67202  
 (316) 263-3238