

CARD MUST BE TYPED

State of Kansas
NOTICE OF INTENTION TO DRILL
(see rules on reverse side)

CARD MUST BE SIGNED

Starting Date: November 30, 1985
month day year

API Number 15-065-22, 278-000
180 West of
NW NE NW Sec 35 Twp 7S S, Rge 23W East
(location) West

OPERATOR: License # 6177
Name Foxfire Exploration, Inc.
Address 1022 Union Center
City/State/Zip Wichita, Kansas 67202
Contact Person D.C. Marchant/M. Starr
Phone 316-265-6296

4950 Ft North from Southeast Corner of Section
3810 Ft West from Southeast Corner of Section
(Note: Locate well on Section Plat on reverse side)

CONTRACTOR: License # 8430
Name Foxfire Drilling Co., Inc.
City/State 1022 Union Center, Wichita, Ks.

Nearest lease or unit boundary line 330 feet.
County Graham
Lease Name Korb Well# 4

Well Drilled For: Well Class: Type Equipment:
 Oil Swd Infield Mud Rotary
 Gas Inj Pool Ext. Air Rotary
 OWWO Expl Wildcat Cable

Domestic well within 330 feet: yes no
Municipal well within one mile: yes no

Depth to Bottom of fresh water 75 feet
Lowest usable water formation Dakota
Depth to Bottom of usable water 1100 feet
Surface pipe by Alternate: 1 2
Surface pipe to be set 294 feet
Conductor pipe if any required feet
Ground surface elevation 2300 Est. feet MSI
This Authorization Expires 5-25-86
Approved By 11-25-85 [Signature] Title

If OWWO: old well info as follows:

Operator
Well Name
Comp Date Old Total Depth
Projected Total Depth 3750 feet
Projected Formation at TD Lansing
Expected Producing Formations Lansing

I certify that we will comply with K.S.A. 55-101, et seq., plus eventually plugging hole to K.C.C. specifications.
We will run a port collar, upper stage cementing to be completed within 3 to 7 days after
Date 11-25-85 running casing Signature of Operator or Agent [Signature] Title President

Must be filed with the K.C.C. five (5) days prior to commencing well
 This card void if drilling not started within six (6) months of date received by K.C.C.

RECEIVED
 STATE CORPORATION COMMISSION


NOV 25 1985

A Regular Section of Land
 1 Mile = 5,280 Ft.

11/25/85
 CONSERVATION DIVISION
 Wichita, Kansas

Important procedures to follow :

1. Notify District office before setting surface casing.
2. Set surface casing by circulating cement to the top.
3. File completion forms ACO-1 with K.C.C. within 90 days of well completion, following instructions on ACO-1, side 1, and including copies of wireline logs.
4. Notify District office 48 hours prior to old well workover or re-entry.
5. Prior to plugging, prepare a plugging plan, then obtain agreement from the appropriate district office for an approved plugging plan.
6. Submit plugging report (CP-4) to K.C.C. after plugging is completed.
7. Obtain an approved injection docket number before disposing of salt water.
8. Notify K.C.C. within 10 days when injection commences or terminates.
9. If an alternate 2 completion, cement in the production pipe from below any usable water to surface within 120 days of spud date.

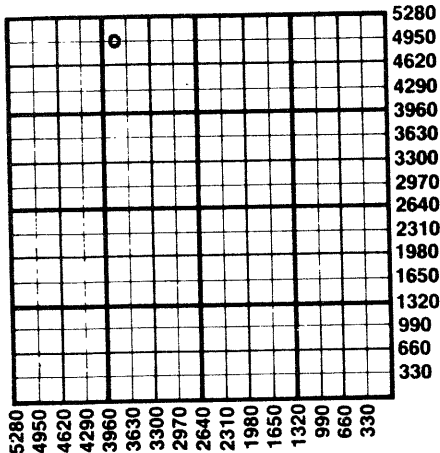

State Corporation Commission of Kansas
 Conservation Division
 200 Colorado Derby Building
 Wichita, Kansas 67202
 (316) 263-3238