


STATE OF KANSAS  
STATE CORPORATION COMMISSION

Give All Information Completely  
Make Required Affidavit  
Mail or Deliver Report to:  
Conservation Division  
State Corporation Commission  
211 No. Broadway  
Wichita, Kansas

15-065-02319-00-00  
WELL PLUGGING RECORD

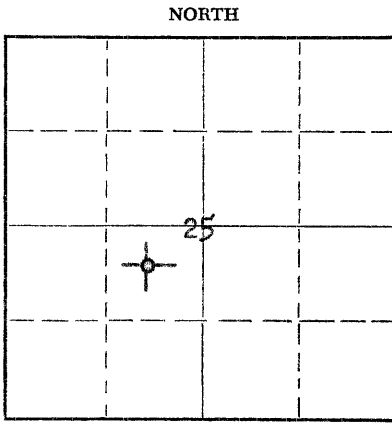

Locate well correctly on above  
Section Plat

Graham County. Sec. 25 Twp. 7 Rge. 23  W  (W)  
Location as "NE/CNW%SW%" or footage from lines C NE SW  
Lease Owner Wood River Oil & Refining Co., Inc.  
Lease Name Fabricius Well No. 1  
Office Address 321 West Douglas, Wichita, Kansas  
Character of Well (completed as Oil, Gas or Dry Hole) Dry Hole  
Date well completed 10-12 19 58  
Application for plugging filed 10-12 19 58  
Application for plugging approved 10-12 19 58  
Plugging commenced 10-12 19 58  
Plugging completed 10-12 19 58  
Reason for abandonment of well or producing formation Dry Hole

If a producing well is abandoned, date of last production \_\_\_\_\_ 19 \_\_\_\_  
Was permission obtained from the Conservation Division or its agents before plugging was commenced? Yes

Name of Conservation Agent who supervised plugging of this well A. D. Fabricius  
Producing formation None Depth to top \_\_\_\_\_ Bottom \_\_\_\_\_ Total Depth of Well 3705 Feet  
Show depth and thickness of all water, oil and gas formations.

OIL, GAS OR WATER RECORDS

CASING RECORD

FORMATION	CONTENT	FROM	TO	SIZE	PUT IN	PULLED OUT
				8 5/8"	245'	None

Describe in detail the manner in which the well was plugged, indicating where the mud fluid was placed and the method or methods used in introducing it into the hole. If cement or other plugs were used, state the character of same and depth placed, from \_\_\_\_\_ feet to \_\_\_\_\_ feet for each plug set.

Heavy Mud up to 600'.  
Pushed wood plug to 600'.  
Placed 20 sacks cement through drill pipe.  
Heavy Mud up to 40'.  
Pushed wooden plug to 40'.  
1/4 sack hulls.  
10 sacks cement to base of well cellar.  
Job completed.

RECEIVED  
STATE CORPORATION COMMISSION  
NOV 8 1958  
CONSERVATION DIVISION  
Wichita, Kansas  
11/8/58

(If additional description is necessary, use BACK of this sheet)  
Name of Plugging Contractor Garvey Drilling Co.  
Address Route #2, Great Bend, Kansas

STATE OF Kansas, COUNTY OF Sedgwick, ss.  
I, H. G. Rippeteau (employee of owner) or (~~owner or operator~~) of the above-described well, being first duly sworn on oath, says: That I have knowledge of the facts, statements, and matters herein contained and the log of the above-described well as filed and that the same are true and correct. So help me God.

(Signature) H. G. Rippeteau  
H. G. Rippeteau  
321 West Douglas, Wichita, Kansas  
(Address)

SUBSCRIBED AND SWORN TO before me this 7th day of November, 19 58

My commission expires 5/17/59  
Ruth H. Roelsing  
Notary Public.

PLUGGING  
FILE SEC. 25 T. 7 R. 23W  
BOOK PAGE 139 LINE 15

15-065-02319-00-00  
WELL LOG

COMPANY **WOODRIVER OIL & REFINING COMPANY**

SEC. **25** T. **7S** R. **23W**

FARM **FABRICIUS** NO. **1**

LOC. **C-NE, SW**


TOTAL DEPTH **3705'**

COUNTY **GRAHAM CO., KANSAS**

COMM. **October 4, 1958**

COMP. **October 12, 1958**

CONTRACTOR **GARVEY DRILLING COMPANY**

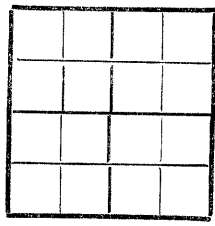

CASING **8 5/8" @ 245' W/160 sax.**

ELEVATION **2244' DF**

PRODUCTION **D & A**

FIGURES INDICATE BOTTOM OF FORMATIONS

65	Surface clay & sand
247	Blue shale
820	Shale
925	Sand & shale w/streaks red bed
1500	Shale & sand
1640	Shale, shells & red bed
1870	Red bed & shale
1915	Anhydrite
2250	Shale
2320	Shale w/lime streaks
2360	Shale & lime
2375	Shale & sand
2685	Lime & shale
2760	Shale
3260	Shale & lime
3380	Lime & shale
3516	Lime & shale w/sand streaks
3705	Lime
3705	T. D.

**PLUGGING**  
 FILE SEC. 25 T. 7 R. 23W  
 BOOK PAGE 139 LINE 15

**RECEIVED**  
 STATE CORPORATION COMMISSION  
 NOV 8 1958  
 CONSERVATION DIVISION  
 Wichita, Kansas  
 11/8/58

State of KANSAS  
 County of BARTON } ss:

I, VERNE A. MORRIS of GARVEY DRILLING COMPANY

upon oath state that the above and foregoing is a true and correct copy of the log of the #1 FABRICIUS well

*Verne A. Morris*

Subscribed and sworn to before me this 23rd day of October 19 58

My Commission Expires: November 12, 1958

*Blanchard*  
 NOTARY PUBLIC