


STATE OF KANSAS  
STATE CORPORATION COMMISSION

Give All Information Completely  
Make Required Affidavit  
Mail or Deliver Report to:  
Conservation Division  
State Corporation Commission  
211 No. Broadway  
Wichita, Kansas

15-065-02623-00-00

WELL PLUGGING RECORD

NORTH

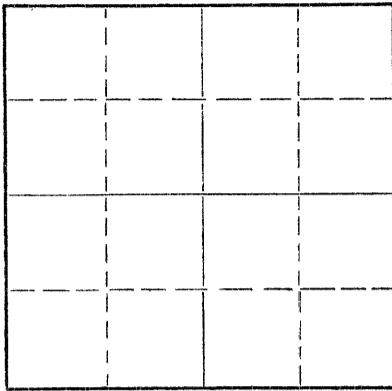

Locate well correctly on above  
Section Plat

Graham County. Sec 25 Twp. 7S Rge. 23W (E)      (W)  
Location as "NE/CNW&SW¼" or footage from lines C SE NE  
Lease Owner Imperial Oil of Kansas, Inc.  
Lease Name Fabricius "A" Well No. 8  
Office Address 780 Fourth National Bldg., Wichita 2, Kansas  
Character of Well (completed as Oil, Gas or Dry Hole) Dry Hole  
Date well completed December 7 1958  
Application for plugging filed December 7 1958  
Application for plugging approved December 7 1958  
Plugging commenced December 7 1958  
Plugging completed December 7 1958  
Reason for abandonment of well or producing formation No commercial quantities of oil found.

If a producing well is abandoned, date of last production      19       
Was permission obtained from the Conservation Division or its agents before plugging was commenced? Yes

Name of Conservation Agent who supervised plugging of this well Mr. A. D. Fabricius  
Producing formation      Depth to top      Bottom      Total Depth of Well 3700 Feet  
Show depth and thickness of all water, oil and gas formations.

OIL, GAS OR WATER RECORDS

CASING RECORD

FORMATION	CONTENT	FROM	TO	SIZE	PUT IN	PULLED OUT
				8-5/8"	225'	225'

Describe in detail the manner in which the well was plugged, indicating where the mud fluid was placed and the method or methods used in introducing it into the hole. If cement or other plugs were used, state the character of same and depth placed, from      feet to      feet for each plug set.

Set No. 1 Plug at 550' with  
20 sacks cement; Set No. 2  
Plug at 220' with 20 sacks of  
cement; Set No. 3 Plug at 40'  
with 10 sacks cement.

(If additional description is necessary, use BACK of this sheet)

Name of Plugging Contractor Imperial Oil of Kansas, Inc.  
Address 780 Fourth National Bldg., Wichita 2, Kansas

STATE OF KANSAS, COUNTY OF SEDGWICK, ss.  
Raymond L. Bacon (employee of owner) or (owner or operator) of the above-described well, being first duly sworn on oath, says: That I have knowledge of the facts, statements, and matters herein contained and the log of the above-described well as filed and that the same are true and correct. So help me God. IMPERIAL OIL OF KANSAS, INC.

(Signature) By: Raymond L. Bacon V-P.  
780 Fourth National Building, Wichita 2, Kansas  
(Address)

SUBSCRIBED AND SWORN TO before me this 24th day of December 19 58

My commission expires July 7, 1962

Mona L. Latier  
Mona L. Latier Notary Public.

RCVD  
24 DEC 58 X

PLUGGING  
FILE SEC 25 T 7 R 23W  
BOOK PAGE 5 LINE 13

15-065-02623-00-00

DRILLER'S LOG

Imperial Oil of Kansas, Inc.  
780 Fourth National Building  
Wichita 2, Kansas

Fabricius "A" No. 8  
C SE NE Sec. 25-7S-23W  
Graham County, Kansas

Total Depth: 3700'

Elevation: 2248' RB  
Production: D & A

Commenced: 11-28-58 Completed: 12-7-58

Contractor: Imperial Oil of Kansas, Inc.  
Wichita 2, Kansas

Casing Record: Set 8-5/8" Surface Pipe at 225' with 165 sacks cement.

Figures indicate bottom of formations:

TOPS

Surface Sand & Clay	225'		
Sand & Shale	1168'	Anhydrite	1845' (✓ 403)
Shells & Shale	1415'	Heebner	3448' (-1200)
Dakota Sand	1620'	Toronto	3474' (-1226)
Shale & Red Bed	1860'	Lansing	3493' (-1245)
Anhydrite	1890'	Base Kansas City	3692' (-1444)
Shale & Shells	2600'	Rotary Total Depth	3700' (-1452)
Shale & Lime	3430'		
Lime	3700'		
Total Depth	3700'		

We hereby certify this to be a correct and accurate log of the above described well as shown on the daily drilling reports.

**RECEIVED**  
STATE CORPORATION COMMISSION  
DEC 30 1958  
CONSERVATION  
Wichita

12/30/58 IMPERIAL OIL OF KANSAS, INC.

By: *Raych Bacon*  
Vice-President

Subscribed and sworn to before me this 24th day of December, 1958.

My Commission Expires:  
July 7, 1962

*Merna L. Sater*  
Notary Public

**PLUGGING**  
FILE SEC. 25 T. 7 R. 23W  
BOOK PAGE 5 LINE 13