


15-141-00030-00-00

WELL PLUGGING RECORD

Give All Information Completely
Make Required Affidavit
Mail or Deliver Report to:
Conservation Division
State Corporation Commission
800 Bittling Building
Wichita, Kansas

NORTH

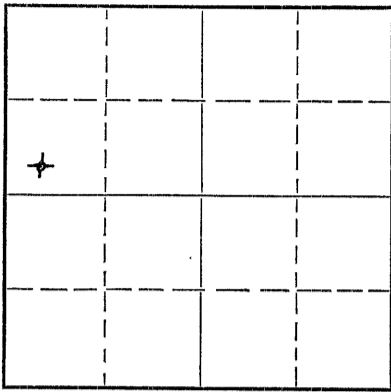

Locate well correctly on above
Section Plat

Osborne County. Sec. 3 Twp. 8S Rge. 15 (E) W (W)
Location as "NE/CNW $\frac{1}{4}$ SW $\frac{1}{4}$ " or footage from lines SW $\frac{1}{4}$ SW $\frac{1}{4}$ NW $\frac{1}{4}$
Lease Owner Anderson-Prichard Oil Corp.
Lease Name Gregory Well No. 1
Office Address Liberty Bank Building, Oklahoma City, Oklahoma
Character of Well (completed as Oil, Gas or Dry Hole) Dry Hole
Date well completed Oct. 20 19 52
Application for plugging filed Oct. 20 19 52
Application for plugging approved Oct. 20 19 52
Plugging commenced Oct. 20 19 52
Plugging completed Oct. 20 19 52
Reason for abandonment of well or producing formation Dry Hole

If a producing well is abandoned, date of last production 19
Was permission obtained from the Conservation Division or its agents before plugging was commenced? Yes

Name of Conservation Agent who supervised plugging of this well C. D. Stough
Producing formation Depth to top Bottom Total Depth of Well 3780 Feet
Show depth and thickness of all water, oil and gas formations.

OIL, GAS OR WATER RECORDS

CASING RECORD

Formation	Content	From	To	Size	Put In	Pulled Out
		0	150'	8 5/8"	150'	None

Describe in detail the manner in which the well was plugged, indicating where the mud fluid was placed and the method or methods used in introducing it into the hole. If cement or other plugs were used, state the character of same and depth placed, from feet to feet for each plug set.

3780' - 146 $\frac{1}{2}$ ' - Heavy Rotary Mud
146 $\frac{1}{2}$ ' - 145' - Wooden Plug
145' - 99' - 15 sacks cement
99' - 41 $\frac{1}{2}$ ' - Heavy Rotary Mud
41 $\frac{1}{2}$ ' - 40' - Wooden Plug
40' - 6' - 10 sacks cement
6' - Surface - Cellar

STATE OF KANSAS
OCT 27 1952
CONSERVATION DIVISION
WICHITA, KANSAS
10-27-52

Name of Plugging Contractor Glenn W. Peel
Address P. O. Box 359, Hoisington, Kansas

STATE OF Kansas, COUNTY OF Barton, SS.
Glenn W. Peel (employee of owner) or (owner or operator) of the above-described well,

being first duly sworn on oath, says: That I have knowledge of the facts, statements, and matters herein contained and the log of the above-described well as filed and that the same are true and correct. So help me God.

(Signature) BY: Glenn W. Peel
P. O. Box 359
Hoisington, Kansas (Address)

SUBSCRIBED AND SWORN to before me this 22nd day of October, 1952

My commission expires June 4, 1955
Marian M. Huber Notary Public.

PLUGGING
FILE SEC 3 T 8 R 1524
BOOK PAGE 53 LINE 43

DRILLER'S LOG

Company: Anderson-Prichard Oil Corp.

SW/4 SW/4 NW/4
Sec. 3 Twp. 8S, Rge. 15W

Farm: Gregory Well No. 1
Total Depth: 3780'

County: Osborne,
Kansas

Comm: 10-7-52 Comp: 10-20-52

Contractor: Glenn W. Peel

Elevation:

Casing: 8 5/8" 150' cem.

Production: Dry

Figures below indicate bottom of formations

Surface Soil	0 -	208
Shale		600
Sand & Shale		1190
Anhydrite		1220
Shale		1780
Shale & Lime		2010
Lime		2230
Shale		2260
Shale & Lime		2330
Shale & Chert		2345
Shale & Lime		2975
Lime		3035
Lime & Shale		3150
Lime		3390
Lime & Shale		3490
Lime		3500
Cherty Lime		3555
Lime		3655
Lime & Sand		3705
Lime		3780
Total Depth		3780

This is to certify that the above information is, to the best of our knowledge true and correct.

GLENN W. PEEL

BY: *Glenn W. Peel*

SUBSCRIBED AND SWORN to before me this 22nd day of October, 1952.

My commission expires June 4, 1955 *Marian M. Hester*
Notary Public

REC-
STATE CORP.
OCT 27 1952
CONSERVATION DIVISION
Wichita, Kansas

PLUGGING
WELL SEC 3 T 8 R 1524
BOOK PAGE 53 LINE 43