


STATE OF KANSAS
STATE CORPORATION COMMISSION

WELL PLUGGING RECORD

Give All Information Completely
Make Required Affidavit
Mail or Deliver Report to
Conservation Division
State Corporation Comm.
245 North Water
Wichita, KS 67202

Graham County, Sec. 12 Twp. 7 S Rge. 23 E/W
Location as "NE/CNW $\frac{1}{2}$ SW $\frac{1}{2}$ " or footage from lines
SW NE NW

Lease Owner F & M Oil Company
Lease Name Drury Well No. 1
Office Address 505 Union Center, Wichita, Kansas 67202
Character of Well (Completed as Oil, Gas or Dry Hole)
Dry Hole

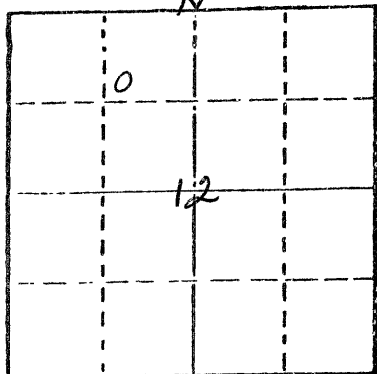

Locate well correctly on above
Section Plat

Date Well completed Aug. 20, 1978
Application for plugging filed (verbally) Aug. 20, 1978
Application for plugging approved (verbally) Aug. 20, 1978
Plugging commenced Aug. 20, 1978
Plugging completed Aug. 20, 1978
Reason for abandonment of well or producing formation
No commercial quantity of oil or gas encountered
If a producing well is abandoned, date of last production 19

Was permission obtained from the Conservation Division or
its agents before plugging was commenced? Yes

Name of Conservation Agent who supervised plugging of this well Gilbert Balthazor
Producing formation Depth to top Bottom Total Depth of Well 3900'
Show depth and thickness of all water, oil and gas formations.

OIL, GAS OR WATER RECORDS

CASING RECORD

FORMATION	CONTENT	FROM	TO	SIZE	PUT IN	PULLED OUT

Describe in detail the manner in which the well was plugged, indicating where the mud fluid
was placed and the method or methods used in introducing it into the hold. If cement or other
plugs were used, state the character of same and depth placed, from _____ feet to
_____ feet for each plug set.

Set 1st plug at 1000' with 70 sacks
2nd plug at 240' with 20 sacks
3rd plug at 40' solid bridge with 10 sacks
Cemented with 50-50 posmix, 6% gel.

RECEIVED
STATE CORPORATION COMMISSION

AUG 24 1978

CONSERVATION DIVISION
Wichita, Kansas

(If additional description is necessary, use BACK of this sheet)

Name of Plugging Contractor Abercrombie Drilling, Inc. 8/24/78

STATE OF KANSAS COUNTY OF SEDGWICK, ss.
Jack L. Partridge, Ass't. Secretary-Treasurer (employee of owner) or (owner or operator)
of the above-described well, being first duly sworn on oath, says: That I have knowledge of
the facts, statements, and matters herein contained and the log of the above-described well
as filed and that the same are true and correct. So help me God.

(Signature) Jack L. Partridge
801 Union Center, Wichita, Kansas 67202
(Address)



SUBSCRIBED AND SWORN TO before me this 23rd day of August, 1978

Sandra Richman
Sandra Richman Notary Public.

OPERATOR: F & M Oil Company
 CONTRACTOR: Abercrombie Drilling, Inc.
 WELL NAME: Drury #1
 LOCATION: SW NE NW Section 12-7S-23W
 Graham County, Kansas
 SPUD DATE: August 12, 1978
 COMPLETION DATE: August 20, 1978

0	255	Surface soil, sand & shale
255	923	Shale & sand
923	1834	Sand & shale
1834	2087	Shale & sand
2087	2119	Anhydrite
2119	2554	Shale & shells
2554	2730	Shale
2730	2937	Shale & lime
2937	3108	Lime & shale
3108	3174	Shale & lime
3174	3489	Lime & shale
3489	3720	Shale & lime
3720	3740	Lime & shale
3740	3802	Shale & lime
3802	3900	Lime & shale
	3900	Rotary Total Depth

Spud hole at 5:30 p.m., August 12, 1978. Drilled 255' of 12 1/4" hole. Ran 6 joints of 8-5/8" - 28# surface casing. Set at 250.50' with 180 sacks 60-40 posmix, 2% gel, 3% CaCl. Cement did circulate. Plug was down at 11:45 p.m., August 12, 1978.

T.D. 3900'. Set first plug at 1000' with 70 sacks, second plug at 240' with 20 sacks, third plug at 40' - solid bridge - with 10 sacks. Cemented with 50-50 posmix, 6% gel. Job complete at 5:30 p.m., August 20, 1978. State Plugger - Gilbert Balthazor.

SAMPLE TOPS:

Anhydrite 2088'
 B/Anhydrite 2119'

RECEIVED
 STATE COMMISSION

AUG 24 1978

STATE OF KANSAS)
) ss
 COUNTY OF SEDGWICK)

CONSERVATION DIVISION
 Wichita, Kansas

8/24/78

Jack L. Partridge, Assistant Secretary-Treasurer of Abercrombie Drilling, Inc., does hereby state that the above and foregoing is a true and correct copy of the log of the Drury #1, SW NE NW Section 12-7S-23W, Graham County, Kansas.

ABERCROMBIE DRILLING, INC.

BY Jack L. Partridge
 Jack L. Partridge,
 Assistant Secretary-Treasurer

Subscribed and sworn to before me, a Notary Public, in and for the county and state aforesaid, as of this 23rd day of August, 1978.



Sandra Richman
 Sandra Richman, Notary Public

My commission expires July 21, 1979.