


15-065-19065-00-00

STATE OF KANSAS
STATE CORPORATION COMMISSION

Give All Information Completely
Make Required Affidavit
Mail or Deliver Report to:
Conservation Division
State Corporation Commission
212 North Market, Insurance Bldg.
Wichita, Kansas

WELL PLUGGING RECORD

NORTH

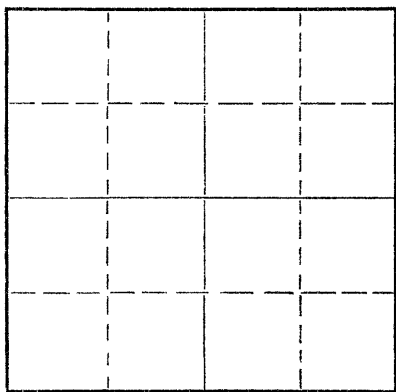

Locate well correctly on above
Section Plat

GRAHAM County. Sec. 12 Twp. 7 Rge. 23W (E) (W)
Location as "NE/CNW/SW" or footage from lines C NE NW
Lease Owner IMPERIAL OIL OF KANSAS, INC.
Lease Name DRURY (CORE HOLE) Well No. 2
Office Address 780 FOURTH NATIONAL BUILDING., WICHITA 2, KANSAS
Character of Well (completed as Oil, Gas or Dry Hole) DRY HOLE
Date well completed JULY 2 19.59
Application for plugging filed JULY 2 19.59
Application for plugging approved JULY 2 19.59
Plugging commenced JULY 2 19.59
Plugging completed JULY 2 19.59
Reason for abandonment of well or producing formation CORE HOLE

If a producing well is abandoned, date of last production 19
Was permission obtained from the Conservation Division or its agents before plugging was commenced? YES

Name of Conservation Agent who supervised plugging of this well MR. A.D. FABRICIUS
Producing formation Depth to top Bottom Total Depth of Well 2635 Feet
Show depth and thickness of all water, oil and gas formations.

OIL, GAS OR WATER RECORDS

CASING RECORD

FORMATION	CONTENT	FROM	TO	SIZE	PUT IN	PULLED OUT

Describe in detail the manner in which the well was plugged, indicating where the mud fluid was placed and the method or methods used in introducing it into the hole. If cement or other plugs were used, state the character of same and depth placed, from feet to feet for each plug set.

NO. 1 PLUG SET AT 300' WITH 10 SACKS
CEMENT; NO. 2 PLUG SET AT 140' WITH
10 SACKS CEMENT; TOP PLUG SET AT 40'
WITH 5 SACKS CEMENT.

RECEIVED
STATE CORPORATION COMMISSION

NOV 4 1959

CONSERVATION DIVISION
Wichita, Kansas

11/4/59

(If additional description is necessary, use BACK of this sheet)
Name of Plugging Contractor CHEM-TECH
Address BOX 728, HILL CITY, KANSAS

STATE OF KANSAS, COUNTY OF GRAHAM, ss.
DANIEL F. MCCARTHY (employee of owner) or (owner or operator) of the above-described well, being first duly sworn on oath, says: That I have knowledge of the facts, statements, and matters herein contained and the log of the above-described well as filed and that the same are true and correct. So help me God.

(Signature) Daniel F. McCarthy
BOX 728 HILL CITY, KANSAS
(Address)

SUBSCRIBED AND SWORN TO before me this 3rd day of November, 1959

My commission expires January 22, 1960
My commission expires

Carroll Rexler
Notary Public.



15-065-19065-00-00

RECEIVED
STATE CORPORATION COMMISSION

NOV 4 1959

CONSERVATION DIVISION
Wichita, Kansas

11/4/59

DRILLER'S LOG

IMPERIAL OIL OF KANSAS, INC.
780 FOURTH NATIONAL BUILDING
WICHITA 2, KANSAS

DRURY CORE HOLE NO. 2
C NE NW 12-7-23W
GRAHAM COUNTY, KANSAS

TOTAL DEPTH: 2680'

ELEVATION: 2402 K.B.

COMMENCED: 6-28-59 COMPLETED: 7-2-59

CONTRACTOR: CHEM-TECH -- BOX 728
HILL CITY, KANSAS

ALL TOPS AND BOTTOMS OF THE FORMATIONS ARE CONFIDENTIAL INFORMATION OF THE GEOLOGICAL
DEPARTMENT OF IMPERIAL OIL OF KANSAS, INC.
780 FOURTH NATIONAL BUILDING
WICHITA 2, KANSAS

WE HEREBY CERTIFY THIS TO BE A CORRECT AND ACCURATE LOG OF THE ABOVE DESCRIBED WELL,
AS SHOWN ON THE DAILY DRILLING REPORTS.

CHEMICAL & TECHNICAL SERVICES, INC.

BY: Daniel F. McCarthy
ASSISTANT TREASURER

SUBSCRIBED AND SWORN TO BEFORE ME THIS 3rd DAY OF November, 1959.

MY COMMISSION EXPIRES:

My Commission Expires January 23, 1960

Norm Sessler
NOTARY PUBLIC