


STATE OF KANSAS
STATE CORPORATION COMMISSION

WELL PLUGGING RECORD

Give All Information Completely
Make Required Affidavit
Mail or Deliver Report to
Conservation Division
State Corporation Comm.
245 North Water
Wichita, KS 67202

Graham County, Sec. 17 Twp. 7S Rge. 23W 1/4 NW
Location as "NE/CNW 1/4 SW 1/4" or footage from lines
C NW/4 NE/4 NE/4
Lease Owner Graham-Michaelis Corporation
Lease Name Brant Well No. 1-17
Office Address 211 North Broadway, Wichita, Kansas 67202
Character of Well (Completed as Oil, Gas or Dry Hole) D & A
Date Well completed May 20, 1980
Application for plugging filed May 20, 1980
Application for plugging approved May 20, 1980
Plugging commenced May 20, 1980
Plugging completed May 20, 1980
Reason for abandonment of well or producing formation D & A

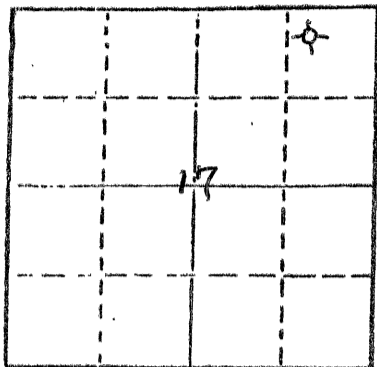

Locate well correctly on above
Section Plat

If a producing well is abandoned, date of last production 19

Was permission obtained from the Conservation Division or its agents before plugging was commenced? Yes

Name of Conservation Agent who supervised plugging of this well Gil Balthazor
Producing formation Depth to top Bottom Total Depth of Well 3,965'
Show depth and thickness of all water, oil and gas formations.

OIL, GAS OR WATER RECORDS

CASING RECORD

FORMATION	CONTENT	FROM	TO	SIZE	PUT IN	PULLED OUT
				8 5/8"	281'	-0-

Describe in detail the manner in which the well was plugged, indicating where the mud fluid was placed and the method or methods used in introducing it into the hold. If cement or other plugs were used, state the character of same and depth placed, from feet to feet for each plug set.

Plugs @ 1,050' w/70 sx cement
@ 270' w/20 sx cement
@ 40' w/Bridge & 10 sx cement 6/2/80
5 sx cement in rathole

RECEIVED
JUN 2 1980
CONSERVATION DIVISION
Wichita, Kansas

(If additional description is necessary, use BACK of this sheet)


Name of Plugging Contractor Red Tiger Drilling Company
1720 KSB&T Building, Wichita, Kansas 67202

STATE OF Kansas COUNTY OF Sedgwick
Gloria Fawcett (employee of ~~XXXXXX~~ contractor)
of the above-described well, being first duly sworn on oath, says: That I have knowledge of the facts, statements, and matters herein contained and the log of the above-described well as filed and that the same are true and correct. So help me God.

(Signature) Gloria Fawcett
1720 KSB&T Building, Wichita, Kansas 67202
(Address)

SUBSCRIBED AND SWORN TO before me this 28th day of May, 1980.

My commission expires _____
Joyce A. Hagermann Notary Public.

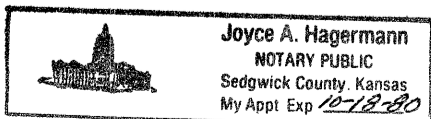

DRILLERS LOG

No. 1-17 Brant

CASING RECORD: 8 5/8" @ 286' w/200 sx cement
 D & A
 TOTAL DEPTH: 3,965'

COMPANY: Graham-Michaelis Corporation
 CONTRACTOR: Red Tiger Drilling Company
 COMMENCED: May 10, 1980
 COMPLETED: May 20, 1980

DESCRIPTION: C NW/4 NE/4 NE/4
 Sec. 17-T7S-R23W
 Graham County, Kansas
 ELEVATION: 2,418' KB

<u>FORMATION</u>	<u>FROM</u>	<u>TO</u>	<u>REMARKS</u>
Sand & Shale	0	295	
Shale	295	990	
Sand	990	1160	
Shale	1160	1200	
Shale & Sand Streaks	1200	1666	
Sand	1666	1869	
Shale	1869	2107	
Anhydrite	2107	2143	
Shale	2143	2645	
Shale & Lime Streaks	2645	2800	
Shale & Lime	2800	3300	
Lime	3300	3965	
RTD		3965	


I certify that this is a true and correct copy of the above log to the best of my knowledge.

RED TIGER DRILLING COMPANY

Gloria Fawcett
Gloria Fawcett

Subscribed and sworn to before me this 28th day of May, 1980.

Joyce A. Hagermann
Notary Public

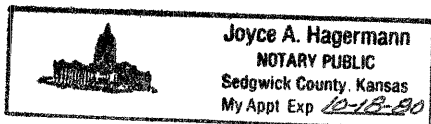

RECEIVED
 DEPARTMENT OF REVENUE
 JUN 2 1980
 REVENUE DIVISION
 Topeka, Kansas

6/2/80