


Give All Information Completely
Make Required Affidavit
Mail or Deliver Report to:
Conservation Division
State Corporation Commission
211 No. Broadway
Wichita, Kansas

15-065-00622-00-00

WELL PLUGGING RECORD

NORTH

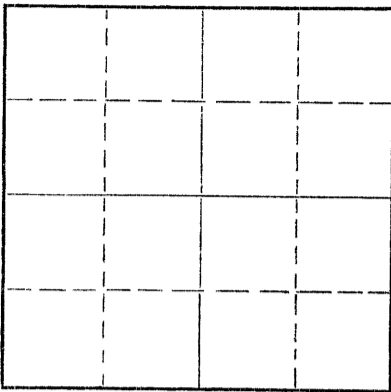

Locate well correctly on above
Section Plat

Graham County. Sec. 22 Twp. 7S Rge. 23W (E) (W)
Location as "NE/CNW/SW" or footage from lines SW SW SW
Lease Owner Veeder Supply and Development Co. et al
Lease Name Moore Well No. 1
Office Address Box 201, Cherryvale, Kansas
Character of Well (completed as Oil, Gas or Dry Hole) Dry Hole
Date well completed 7-31-58 19
Application for plugging filed 7-31-58 19
Application for plugging approved 7-31-58 19
Plugging commenced 7-31-58 19
Plugging completed 7-31-58 19
Reason for abandonment of well or producing formation dry hole

If a producing well is abandoned, date of last production _____ 19
Was permission obtained from the Conservation Division or its agents before plugging was commenced? Yes

Name of Conservation Agent who supervised plugging of this well A. D. Fabricus, Hill City, Kansas
Producing formation _____ Depth to top _____ Bottom _____ Total Depth of Well 4125 Feet
Show depth and thickness of all water, oil and gas formations.

OIL, GAS OR WATER RECORDS

CASING RECORD

FORMATION	CONTENT	FROM	TO	SIZE	PUT IN	PULLED OUT
				8 5/8"	225' w/140 sacks	

Describe in detail the manner in which the well was plugged, indicating where the mud fluid was placed and the method or methods used in introducing it into the hole. If cement or other plugs were used, state the character of same and depth placed, from _____ feet to _____ feet for each plug set.

Mud to 550', plug with 25 sacks cement; mud to 220', plug with 1/2 sack hulls, 15 sacks cement; mud to 40' ~~with 1/2~~ plug w/1/2 sack hulls 10 sacks cement.

(If additional description is necessary, use BACK of this sheet)
Name of Plugging Contractor Veeder Supply and Development Co.
Address Box 201, Cherryvale, Kansas

STATE OF Kansas, COUNTY OF Montgomery, ss.
C. H. Woods (employee of owner) or (~~owner or operator~~) of the above-described well, being first duly sworn on oath, says: That I have knowledge of the facts, statements, and matters herein contained and the log of the above-described well as filed and that the same are true and correct. So help me God.

(Signature) C. H. Woods
Cherryvale, Kansas
(Address)

SUBSCRIBED AND SWORN TO before me this 4th day of August, 19 58

My commission expires July 11, 1960


Kyle Lawson
Notary Public.

PLUGGING
FILE SEC. 22 T. 7 R. 23W
BOOK PAGE 121 LINE 29

RECORDED
STATE CORPORATION COMMISSION
AUG 19 1958
8/18/58
CONSERVATION DIVISION

15-065-00622-08-00

Veeder Supply & Dev'l. Co.

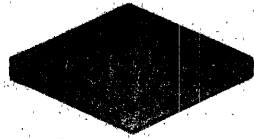

Cherryvale, Kansas

Aurora Gasoline Company,
 Drilled for Veeder Supply & Development Co. et al Farm Moore No. 1 Depth 4125'
 Contractor Veeder Supply & Development Co. Pipe 225' 8 5/8" csg. w/110 sacks
 Location SW/4 SW/4 SW/4 Sec. 22 Twp. 7S Range 23W
 Commenced 7-21-58 Completed 7-31-58 County Graham State Kansas

Soil, yellow shale	0	34	34	ELEVATION; 2348 DF	
Shale sand	34	110	76		
Shale	110	900	790	TOPS:	
Sand, shale	900	1270	370	Heebner	3602'
Shale and sand streaks	1270	1605	335	Toronto	3628
Sand and shale	1605	1840	235	Lansing	3632
Shale, shells, red bed	1840	2035	195	Base KC	3843
Anhydrite	2035	2073	38	Marmaton	3868
Shale and shells	2073	2495	422	Cherty Cong.	4028
Shale w/lime streaks	2495	2575	80	Arbuckle	4091
Shale lime	2575	2700	125		
Lime and shale	2700	2775	75		
Shale and lime	2775	2945	170		
Lime shale	2945	3470	525		
Shale lime	3470	3555	85		
Lime	3555	3985	430		
Shale and lime	3985	4035	50		
Chert lime	4035	4080	45		
Cong. Cherty	4080	4088	8		
Arbuckle	4088	4125	37		
T. D.	4125				

D&A

AFFIDAVIT

STATE OF KANSAS)
Montgomery County) ss

C. H. Woods, of lawful age, being first duly sworn on oath, deposes and says:

THAT he has read the above drilling log covering the Moore #1 well located in Section 22-7S-23W. Graham County, Kansas, and that the same is true and correct. Further affiant saith not.

THE VEEDER SUPPLY AND DEVELOPMENT CO.

BY C. H. Woods
C. H. Woods

Subscribed and sworn to before me this 4th day of August, 1958.

Edna Lawson
Notary Public

My commission expires July 11, 1960.

PLUGGING
 FILE SEC. 22 T. 7 R. 23W
 BOOK PAGE 121 LINE 21

8/18/58