

15-065-61062-00-00


STATE OF KANSAS  
STATE CORPORATION COMMISSION

Form CP-4

Give All Information Completely  
Make Required Affidavit  
Mail or Deliver Report to:  
Conservation Division  
State Corporation Commission  
211 No. Broadway  
Wichita, Kansas

WELL PLUGGING RECORD

NORTH

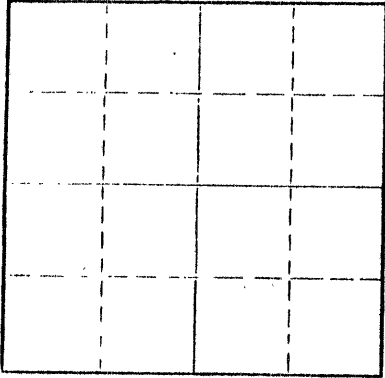

Locate well correctly on above  
Section Plat

Graham County, Sec. 22 Twp. 7S Rge. 23 (E) (W)

Location as "NE/CNW&SWK" or footage from lines C NW SE

Lease Owner Fred B. Anschutz

Lease Name Moore Well No. 1

Office Address 1521 Wichita Plaza, Wichita, Kansas

Character of Well (completed as Oil, Gas or Dry Hole) Dry hole

Date well completed 9-2 19 64

Application for plugging filed 9-2 19 64

Application for plugging approved 9-2 19 64

Plugging commenced 9-2 19 64

Plugging completed 9-2 19 64

Reason for abandonment of well or producing formation None

If a producing well is abandoned, date of last production 19

Was permission obtained from the Conservation Division or its agents before plugging was commenced? Yes

Name of Conservation Agent who supervised plugging of this well \_\_\_\_\_

Producing formation \_\_\_\_\_ Depth to top \_\_\_\_\_ Bottom \_\_\_\_\_ Total Depth of Well 3960 Feet

Show depth and thickness of all water, oil and gas formations.

OIL, GAS OR WATER RECORDS

CASING RECORD

FORMATION	CONTENT	FROM	TO	SIZE	PUT IN	PULLED OUT
		0	150	8 5/8	150	-0-

Describe in detail the manner in which the well was plugged, indicating where the mud fluid was placed and the method or methods used in introducing it into the hole. If cement or other plugs were used, state the character of same and depth placed, from \_\_\_\_\_ feet to \_\_\_\_\_ feet for each plug set.

Filled hole with mud to 540',  
plug, 20 sks. cement. Mud to  
140', plug, 20 sks. cement.  
Mud to 40', plug, 1/2 sk. hulls,  
10 sks. cement.

RECEIVED  
STATE CORPORATION COMMISSION

SEP 14 1964

CONSERVATION DIVISION  
Wichita, Kansas

9/14/64

(If additional description is necessary, use BACK of this sheet)

Name of Plugging Contractor Terrel Drilling and Producing

Address Box 606, Russell, Kansas

STATE OF KANSAS, COUNTY OF RUSSELL, ss.  
Joe K. Branum

(Employer or owner or (owner or operator) of the above-described well, being first duly sworn on oath, says: That I have knowledge of the facts, statements, and matters herein contained and the log of the above-described well as filed and that the same are true and correct. So help me God.

(Signature) Joe K. Branum

Russell, Kansas  
(Address)

SUBSCRIBED AND SWORN to before me this 8th day of September, 19 64

My commission expires 12-12-66

L. L. Simpson  
Notary Public.

15-065-01062-0000

W E L L L O G

OPERATOR: Fred B. Anschutz  
1521 Wichita Plaza  
Wichita, Kansas

CONTRACTOR: Terrel Drilling & Producing  
Box 606  
Russell, Kansas

LEASE: Moore #1

COMMENCED: August 24, 1964

LOCATION: C NW SE, Sec. 22-7S-23W  
Graham County, Kansas


COMPLETED: September 2, 1964

DEPTHS & FORMATIONS

Clay & Sand	70	Shale	2080
Shale	495	Shale & Shells	2830
Shale & Shells	1385	Lime & Shale	3010
Shale	1510	Lime	3120
Sand & Shale	1725	Lime & Shale	3585
Red Bed	1960	Lime (R.T.D.)	3960
Anhydrite	2002		

STATE OF KANSAS )  
                          )  
COUNTY OF RUSSELL) ss...

Joe K. Branum, owner of Terrel Drilling and Producing, being first duly sworn on oath says: "That I have knowledge of the facts, statements and matters herein contained and the log of the above described well as filed and that the same are true and correct."

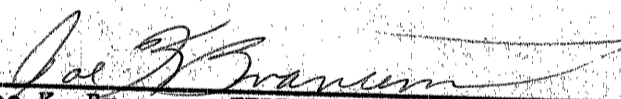  
\_\_\_\_\_  
Joe K. Branum - TERREL DRILLING AND PRODUCING

Subscribed and sworn before me this 8th day of September, 1964.

  
\_\_\_\_\_  
Notary Public

My Commission Expires December 12, 1966.

RECORDED

9/14/64