


STATE OF KANSAS  
STATE CORPORATION COMMISSION

Give All Information Completely  
Make Required Affidavit  
Mail or Deliver Report to:  
Conservation Division  
State Corporation Commission  
211 No. Broadway  
Wichita, Kansas

15-065-00941-00-00  
WELL PLUGGING RECORD

NORTH

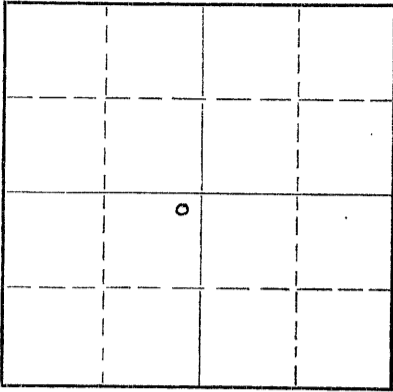

Locate well correctly on above  
Section Plat

Graham County. Sec. 17 Twp. 7S Rge. 23 (X) (W)  
Location as "NE/CNW/SW" or footage from lines NE NE SW  
Lease Owner Anschutz Drilling Co., Inc.  
Lease Name Kobler Well No. 1  
Office Address 709 Union Natl. Bank Bldg., Wichita, Ks.  
Character of Well (completed as Oil, Gas or Dry Hole) Dry Hole  
Date well completed June 24 1956  
Application for plugging filed June 24 1956  
Application for plugging approved June 24 1956  
Plugging commenced June 24 1956  
Plugging completed June 25 1956  
Reason for abandonment of well or producing formation Dry

If a producing well is abandoned, date of last production \_\_\_\_\_ 19\_\_\_\_  
Was permission obtained from the Conservation Division or its agents before plugging was commenced? Yes

Name of Conservation Agent who supervised plugging of this well Eldon Petty  
Producing formation \_\_\_\_\_ Depth to top \_\_\_\_\_ Bottom \_\_\_\_\_ Total Depth of Well 3930 Feet  
Show depth and thickness of all water, oil and gas formations.

OIL, GAS OR WATER RECORDS

CASING RECORD

FORMATION	CONTENT	FROM	TO	SIZE	PUT IN	PULLED OUT
				8-5/8"	197	

Describe in detail the manner in which the well was plugged, indicating where the mud fluid was placed and the method or methods used in introducing it into the hole. If cement or other plugs were used, state the character of same and depth placed, from \_\_\_\_\_ feet to \_\_\_\_\_ feet for each plug set.

Drove down 1/3 sack of hulls.  
Drilled Haliburton plug to 190', 15 sacks cement.  
Set top plug at 40' with 10 sacks cement.

(If additional description is necessary, use BACK of this sheet)

Name of Plugging Contractor Kan-Tex Drillers, Inc.  
Address 413 Beacon Bldg., Wichita, Kansas

STATE OF Kansas, COUNTY OF Sedgwick, ss.  
Shirley Salley (employee of owner) or (owner or operator) of the above-described well, being first duly sworn on oath, says: That I have knowledge of the facts, statements, and matters herein contained and the log of the above-described well as filed and that the same are true and correct. So help me God.

(Signature) Shirley Salley Shirley Salley  
709 Union Natl. Bk. Bldg., Wichita, Kansas  
(Address)

SUBSCRIBED AND SWORN TO before me this 25th day of June, 1956

My commission expires April 27, 1959

Kenneth R. Swenson  
Kenneth R. Swenson  
Notary Public.

PLUGGING  
FILE SEC 17 T 7 R 23W  
BOOK PAGE 75 LINE 6

6/28/56

DRILLERS' LOG

No. 1 Kobler  
NE 1/4 NE 1/4 SW 1/4 Section 17-7S-23W  
Graham County, Kansas

FROM	TO	
0	120	Shale and sand
120	165	Sand and shale
165	207	Shale
207	774	Shale and sand
774	800	Sand
800	1230	Shale and sand
1230	1340	Dakota
1340	1475	Sand
1475	1675	Shale and sand
1675	1885	Sand
1885	2105	Shale and sand
2105	2160	Anhy.
2160	2216	Shale and anhy.
2216	2511	Red bed and shale
2511	2699	Shale and shells
2699	2970	Lime and shale
2970	3263	Shale and lime
3263	3358	Shale and shells
3358	3662	Lime and shale
3662	3873	Lime
3873	3930	Lime and shale
	3930	Rotary total depth D & A

COMMENCED: 6-15-56

COMPLETED: 6-25-56

CASING RECORD:

Set 197' of 8 5/8" surface casing with 135 sacks cement, 2% calcium chloride.

STATE FOR KANSAS )  
                          ) S S  
COUNTY OF SEDGWICK )

I hereby affirm that the above and foregoing is a true and correct copy of the formationa encountered on the No. 1 Kobler, NE 1/4, NE 1/4, SW 1/4 Section 17-7S-23W, Graham County, Kansas, as reflected by the daily drilling reports.

KAN-TEX DRILLERS, INC.

BY: *Harvey E. Nightingale*  
Harvey E. Nightingale

Subscribed and sworn to before me this 26<sup>th</sup> day of June 19 56

My Commission Expires: September 9, 1959

*Donna Rustin*  
Notary Public

PLUGGING  
FILE SEC 17 T 7 R 23 W  
BOOK PAGE 25 LINE 6

RECORDED  
INDEXED  
JUN 29 1956  
DIVISION

6/28/56