

CARD MUST BE TYPED

State of Kansas  
**NOTICE OF INTENTION TO DRILL**  
(see rules on reverse side)

CARD MUST BE SIGNED

Starting Date: ..... 4 ..... 10 ..... 85 .....  
month day year (11.10)

API Number 15- 059-23,884-00-00

OPERATOR: License # 9607  
Name Max Painter  
Address 9865 Fairwood Lane  
City/State/Zip Memphis, Tennessee 38119  
Contact Person Jim Mietchen  
Phone 913 242 2700

..... NW  NE  SW ..... Sec 28 ..... Twp 15 S, Rge 20 .....  
(location)  East  West  
..... 2145 ..... Ft North from Southeast Corner of Section  
..... 3795 ..... Ft West from Southeast Corner of Section  
(Note: Locate well on Section Plat on reverse side)

CONTRACTOR: License # 6807  
Name Oil Drillers & Developers  
City/State 301 Garfield Topeka, KS 66606

Nearest lease or unit boundary line 495 ..... feet.  
County Franklin  
Lease Name Harry Scott ..... Well# 23  
Domestic well within 330 feet:  yes  no  
Municipal well within one mile:  yes  no

Well Drilled For: Well Class: Type Equipment:  
 Oil  Swd  Infield  Mud Rotary  
 Gas  Inj  Pool Ext.  Air Rotary  
 OWWO  Expl  Wildcat  Cable

Depth to Bottom of fresh water ..... none ..... feet  
Lowest usable water formation .....  
Depth to Bottom of usable water ..... 200 ..... feet  
Surface pipe by Alternate: 1  2   
Surface pipe to be set ..... 40 ..... feet  
Conductor pipe if any required ..... feet  
Ground surface elevation ..... feet MSL  
This Authorization Expires ..... 10-9-85 .....  
Approved By ..... 4-9-85 [Signature] .....

If OWWO: old well info as follows:  
Operator .....  
Well Name .....  
Comp Date ..... Old Total Depth .....  
Projected Total Depth ..... 800 ..... feet  
Projected Formation at TD .....  
Expected Producing Formations .....

I certify that we will comply with K.S.A. 55-101, et seq., plus eventually plugging hole to K.C.C. specifications.

Date .. 4/9/85 ..... Signature of Operator or Agent [Signature] Title ..... As agent .....  
Form C-1 4/84

**Must be filed with the K.C.C. five (5) days prior to commencing well**  
**This card void if drilling not started within six (6) months of date received by K.C.C.**


CONSERVATION DIVISION  
Wichita, Kansas

APR 9 1985

4-9-85

**Important procedures to follow :**

A Regular Section of Land  
1 Mile x 3600 Ft.

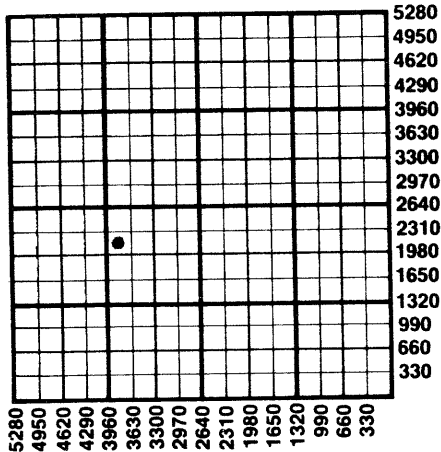

1. Notify District office before setting surface casing.
2. Set surface casing by circulating cement to the top.
3. File completion forms ACO-1 with K.C.C. within 90 days of well completion, following instructions on ACO-1, side 1, and including copies of wireline logs.
4. Notify District office 48 hours prior to old well workover or re-entry.
5. Prior to plugging, prepare a plugging plan, then obtain agreement from the appropriate district office for an approved plugging plan.
6. Submit plugging report (CP-4) to K.C.C. after plugging is completed.
7. Obtain an approved injection docket number before disposing of salt water.
8. Notify K.C.C. within 10 days when injection commences or terminates.
9. If an alternate 2 completion, cement in the production pipe from below any usable water to surface within 120 days of spud date.

**State Corporation Commission of Kansas**  
**Conservation Division**  
**200 Colorado Derby Building**  
**Wichita, Kansas 67202**  
**(316) 263-3238**