

CARD MUST BE TYPED

State of Kansas
NOTICE OF INTENTION TO DRILL
(see rules on reverse side)

CORRECTION
CARD MUST BE SIGNED

15-059-23 887-00-00 *5-24-85*

Starting Date: 5/23/85
month day year

API Number 15-059-23,887 CORRECTION

OPERATOR: License # 9607
Name Max Painter
Address 9845 Fairwood Lane
City/State/Zip Memphis, TN 38119
Contact Person Jerry Hardsaw
Phone 913-242-2700

* SW SW SE ... Sec 28 Twp 15 S, Rge 20 East West
(location)
* 165 Ft North from Southeast Corner of Section
* 2475 Ft West from Southeast Corner of Section
(Note: Locate well on Section Plat on reverse side)

CONTRACTOR: License # 6807
Name Oil Drillers & Developers
City/State Topeka, KS 66606

Nearest lease or unit boundary line 165 feet.
County Franklin
Lease Name Harry Scott Well# 26

Well Drilled For: Well Class: Type Equipment:
 Oil Swd Infield Mud Rotary
 Gas Inj Pool Ext. Air Rotary
 OWWO Expl Wildcat Cable

Domestic well within 330 feet: yes no
Municipal well within one mile: yes no

If OWWO: old well info as follows:
Operator
Well Name
Comp Date Old Total Depth
Projected Total Depth 800 feet
Projected Formation at TD
Expected Producing Formations

Depth to Bottom of fresh water none feet
Lowest usable water formation
Depth to Bottom of usable water 200 feet
Surface pipe by Alternate: 1 2 3
Surface pipe to be set 40 feet
Conductor pipe if any required feet
Ground surface elevation feet MSL
This Authorization Expires 10-9-85
Approved By 4-9-85

I certify that we will comply with K.S.A. 55-101, et seq., plus eventually plugging hole to K.C.C. specifications. *X was: SE SE NW 2805 FSL 2805 FEL*


Date 5/22/85 Signature of Operator or Agent Susan Arnold Title As Agent

CONSERVATION DIVISION
 Wichita, Kansas
**Must be filed with the K.C.C. five (5) days prior to commencing well
 This card void if drilling not started within six (6) months of date received by K.C.C.**

MAY 22 1985
 5-22-85

Important procedures to follow :

A Regular Section of Land
 1 Mile x 3,280 Ft.

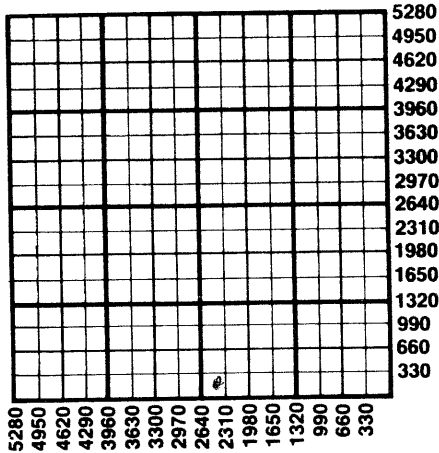

1. Notify District office before setting surface casing.
2. Set surface casing by circulating cement to the top.
3. File completion forms ACO-1 with K.C.C. within 90 days of well completion, following instructions on ACO-1, side 1, and including copies of wireline logs.
4. Notify District office 48 hours prior to old well workover or re-entry.
5. Prior to plugging, prepare a plugging plan, then obtain agreement from the appropriate district office for an approved plugging plan.
6. Submit plugging report (CP-4) to K.C.C. after plugging is completed.
7. Obtain an approved injection docket number before disposing of salt water.
8. Notify K.C.C. within 10 days when injection commences or terminates.
9. If an alternate 2 completion, cement in the production pipe from below any usable water to surface within 120 days of spud date.

**State Corporation Commission of Kansas
 Conservation Division
 200 Colorado Derby Building
 Wichita, Kansas 67202
 (316) 263-3238**