

CARD MUST BE TYPED

State of Kansas  
**NOTICE OF INTENTION TO DRILL**  
(see rules on reverse side)

CARD MUST BE SIGNED

Starting Date: 4/8/85  
..... month day year

API Number 15- 059-23,882-00-00

OPERATOR: License # 9607

SW NE SW Sec 28 Twp 15 S, Rge 20  East  
(location)  West

Name Max Painter

Address 9865 Fairwood Lane

City/State/Zip Memphis, TN 38119

Contact Person Jim Mietchen

Phone 316-242-2700

1815 Ft North from Southeast Corner of Section

3465 Ft West from Southeast Corner of Section

(Note: Locate well on Section Plat on reverse side)

CONTRACTOR: License # 6807

Nearest lease or unit boundary line 165 feet.

County Franklin

Name Oil Drillers & Developers

Lease Name Harry Scott Well# 20

City/State 901 Garfield, Topeka, KS 66606

Domestic well within 330 feet:  yes  no

Well Drilled For: Well Class: Type Equipment:

Municipal well within one mile:  yes  no

Oil  Swd  Infield  Mud Rotary

Depth to Bottom of fresh water none feet

Gas  Inj  Pool Ext.  Air Rotary

Lowest usable water formation ..... feet

OWWO  Expl  Wildcat  Cable

Depth to Bottom of usable water 200 feet

If OWWO: old well info as follows:

Surface pipe by Alternate: 1  2

Operator .....

Surface pipe to be set 40 feet

Well Name .....

Conductor pipe if any required ..... feet

Comp Date ..... Old Total Depth .....

Ground surface elevation ..... feet MSL

Projected Total Depth 800 feet

This Authorization Expires 10-8-85

Projected Formation at TD .....

Approved By R.C.A./K.C.C. 7-8-85

Expected Producing Formations .....

I certify that we will comply with K.S.A. 55-101, et seq., plus eventually plugging hole to K.C.C. specifications.

Date 4/8/85 Signature of Operator or Agent Elaine Parkman

Title as Agent

Form C-1 4/84

AMHC/NOHE 4-9-85


RECEIVED  
STATE CORPORATION COMMISSION

APR 9 1985

Must be filed with the K.C.C. five (5) days prior to commencing well  
This card void if drilling not started within six (6) months of date received by K.C.C.

4-9-85

A Regular Section of Land  
1 Mile = 5,280 Ft.

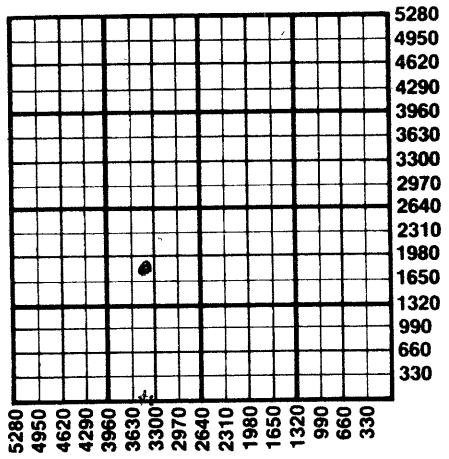

**Important procedures to follow :**

1. Notify District office before setting surface casing.
2. Set surface casing by circulating cement to the top.
3. File completion forms ACO-1 with K.C.C. within 90 days of well completion, following instructions on ACO-1, side 1, and including copies of wireline logs.
4. Notify District office 48 hours prior to old well workover or re-entry.
5. Prior to plugging, prepare a plugging plan, then obtain agreement from the appropriate district office for an approved plugging plan.
6. Submit plugging report (CP-4) to K.C.C. after plugging is completed.
7. Obtain an approved injection docket number before disposing of salt water.
8. Notify K.C.C. within 10 days when injection commences or terminates.
9. If an alternate 2 completion, cement in the production pipe from below any usable water to surface within 120 days of spud date.

State Corporation Commission of Kansas  
Conservation Division  
200 Colorado Derby Building  
Wichita, Kansas 67202  
(316) 263-3238