

CARD MUST BE TYPED

State of Kansas

CARD MUST BE SIGNED

NOTICE OF INTENTION TO DRILL

(see rules on reverse side)

Starting Date 1 11 1986
month day year 3:40

API Number 15- 059-24,131-00-00

OPERATOR: License # 9873 app. NW SW NW
Name Painter Oil Company Inc.
Address Rt. 2, Box 141-B
City/State/Zip Wellsville, Kansas 66092
Contact Person Jerry Hardsaw
Phone 913 242-7310

Sec. 28 Twp. 15 S, Rg. 20 East
3465 West
4785
Ft. from South Line of Section
Ft. from East Line of Section

(Note: Locate well on Section Plat on reverse side)

CONTRACTOR: License # 5666
Name Finch's Drilling Inc.
City/State Rt. 2, Ottawa, Kansas 66067

Nearest lease or unit boundary line 495 feet
County Franklin
Lease Name James Baker Well # 4-B

Well Drilled For: Well Class: Type Equipment:
___ Oil ___ SWD Infield Mud Rotary
___ Gas ___ Inj ___ Pool Ext. ___ Air Rotary
___ OWWO ___ Expl ___ Wildcat ___ Cable

Ground surface elevation na feet MSL

If OWWO: old well info as follows: X Water supply
Operator
Well Name
Comp Date Old Total Depth

Domestic well within 330 feet: ___ yes no
Municipal well within one mile: ___ yes no
Surface pipe by Alternate: 1 ___ 2 1
Depth to bottom of fresh water 60
Depth to bottom of usable water 200
Surface pipe planned to be set 40
Projected Total Depth 800 feet
Formation

I certify that well will comply with K.S.A. 55-101, et seq., plus eventually plugging hole to KCC specifications.

Sherril Kolar

_____ cementing will be done immediately upon setting production casing.

Date 1/10/86 Signature of Operator or Agent *Sherril Kolar* Title as agent

For KCC Use:

Conductor Pipe Required feet; Minimum Surface Pipe Required feet per Alt. 2


This Authorization Expires 7-10-86 Approved By *E* 1-10-86

Must be filed with the K.C.C. five (5) days prior to commencing well
This card void if drilling not started within six (6) months of date received by K.C.C.

Important procedures to follow:

1. Notify District office before setting surface casing.
 2. Set surface casing by circulating cement to the top.
 3. File completion forms ACO-1 with K.C.C. within 90 days of well completion, following instructions on ACO-1, side 1, and including copies of wireline logs.
 4. Notify District office 48 hours prior to old well workover or re-entry.
 5. Prior to filing Intent, prepare a proposed plugging plan in case well is D & A, then obtain approval of plan when calling district office prior to setting surface pipe.
 6. Submit plugging report (CP-4) to K.C.C. after plugging is completed.
 7. Obtain an approved injection docket number before disposing of salt water.
 8. Notify K.C.C. within 10 days when injection commences or terminates.
9. If an alternate 2 completion, cement in the production pipe from below any usable water to surface within 120 days of spud date.

A Regular Section of Land
1 Mile = 5,280 Ft.

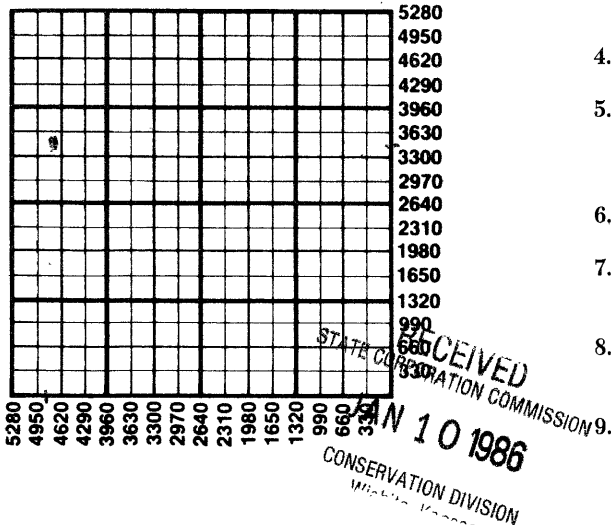

State Corporation Commission of Kansas
Conservation Division
200 Colorado Derby Building
Wichita, Kansas 67202
(316) 263-3238

1-10-86