

CARD MUST BE TYPED

State of Kansas
NOTICE OF INTENTION TO DRILL
(see rules on reverse side)

CARD MUST BE SIGNED

Starting Date: June 11 1985
month day year

API Number 15- 059-23,923-00-00

OPERATOR: License # 9923

App. SE SW NW Sec 28 Twp 15 S, Rge 20 East West

Name All Star Pumping S&W

Address Rt. 1, Box 42

City/State/Zip Pomona, KS 66076

Contact Person Jerry Hardsaw

Phone 913 242 5332

3135 Ft North from Southeast Corner of Section

4125 Ft West from Southeast Corner of Section

(Note: Locate well on Section Plat on reverse side)

CONTRACTOR: License # 6807

Name Oil Drillers & Developers

City/State 901 Garfield, Topeka, KS 66606

Nearest lease or unit boundary line 1125 feet.

County Franklin

Lease Name James Baker Well# 1

Domestic well within 330 feet: yes no

Municipal well within one mile: yes no

Well Drilled For: Well Class: Type Equipment:

- Oil Swd Infield Mud Rotary
- Gas Inj Pool Ext. Air Rotary
- OWWO Expl Wildeat Cable

Depth to Bottom of fresh water none feet

Lowest usable water formation

Depth to Bottom of usable water 200 feet

Surface pipe by Alternate: 1 2

Surface pipe to be set 40 feet

Conductor pipe if any required feet

Ground surface elevation feet MSL

This Authorization Expires 12-11-85

Approved By 6-11-85 [Signature]

If OWWO: old well info as follows:

Operator

Well Name

Comp Date Old Total Depth

Projected Total Depth 800 feet

Projected Formation at TD Squirrel

Expected Producing Formations

I certify that we will comply with K.S.A. 55-101, et seq., plus eventually plugging hole to K.C.C. specifications.

Date 6/11/85 Signature of Operator or Agent Elaine Berham Title as agent

Form C-1 4/84

MHC/KOHE 6-11-85


Must be filed with the K.C.C. five (5) days prior to commencing well
 This card void if drilling not started within six (6) months of date received by K.C.C.

6-11-85

RECEIVED
 3/22/85
 A Regular Section of Land
 1 Mile
 STATE CORPORATION COMMISSION
 JUN 1 1985
 CONSERVATION DIVISION
 Wichita, Kansas

Important procedures to follow :

1. Notify District office before setting surface casing.
2. Set surface casing by circulating cement to the top.
3. File completion forms ACO-1 with K.C.C. within 90 days of well completion, following instructions on ACO-1, side 1, and including copies of wireline logs.
4. Notify District office 48 hours prior to old well workover or re-entry.
5. Prior to plugging, prepare a plugging plan, then obtain agreement from the appropriate district office for an approved plugging plan.
6. Submit plugging report (CP-4) to K.C.C. after plugging is completed.
7. Obtain an approved injection docket number before disposing of salt water.
8. Notify K.C.C. within 10 days when injection commences or terminates.
9. If an alternate 2 completion, cement in the production pipe from below any usable water to surface within 120 days of spud date.

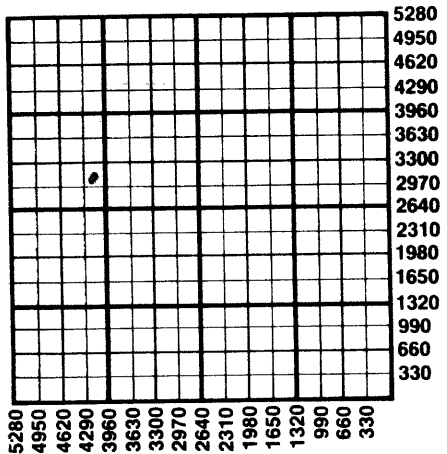

State Corporation Commission of Kansas
 Conservation Division
 200 Colorado Derby Building
 Wichita, Kansas 67202
 (316) 263-3238