

CARD MUST BE TYPED

State of Kansas
NOTICE OF INTENTION TO DRILL
(see rules on reverse side)

CARD MUST BE SIGNED

Starting Date: 6 26 85
month day year 2:40

API Number 15- 059-2395100-00

OPERATOR: License # 9873
Name Painter Oil Co. Inc
Address 9865 Fairwood Lane
City/State/Zip Memphis, Tennessee 38119
Contact Person Jerry Hardsaw
Phone 913 242-7310

.. SW SW NE .. Sec 28 .. Twp .. 15 S, Rge .. 20 ..
(location) East West
..... 313.5 Ft North from Southeast Corner of Section
..... 247.5 Ft West from Southeast Corner of Section
(Note: Locate well on Section Plat on reverse side)

CONTRACTOR: License # 6807
Name Oil Drillers & Developers Inc
City/State 301 Garfield Topeka, KS 66606

Nearest lease or unit boundary line 16.5 feet.
County Franklin

Well Drilled For: Well Class: Type Equipment:
 Oil Swd Infield Mud Rotary
 Gas Inj Pool Ext. Air Rotary
 OWWO Expl Wildcat Cable

Lease Name Harry Scott Well# 30

Domestic well within 330 feet: yes no
Municipal well within one mile: yes no

If OWWO: old well info as follows:
Operator
Well Name
Comp Date Old Total Depth
Projected Total Depth 800 feet
Projected Formation at TD
Expected Producing Formations

Depth to Bottom of fresh water none feet
Lowest usable water formation Douglas Group
Depth to Bottom of usable water 200 feet
Surface pipe by Alternate: 1 2
Surface pipe to be set 40 feet
Conductor pipe if any required feet
Ground surface elevation feet MSL
This Authorization Expires 12-26-85
Approved By 6-26-85 [Signature]

I certify that we will comply with K.S.A. 55-101, et seq., plus eventually plugging hole to K.C.C. specifications.

Date 6/26/85 Signature of Operator or Agent [Signature] Title As agent

Must be filed with the K.C.C. five (5) days prior to commencing well
This card void if drilling not started within six (6) months of date received by K.C.C.

6-26-85

RECEIVED
STATE CORPORATION COMMISSION

Important procedures to follow:

A Regular Section of Land
1 Mile = 5,280 Ft.

JUN 26 1985

1. Notify District office before setting surface casing.

2. Set surface casing by circulating cement to the top.

CONSERVATION DIVISION
Wichita, Kansas

3. File completion forms ACO-1 with K.C.C. within 90 days of well completion, following instructions on ACO-1, side 1, and including copies of wireline logs.

4. Notify District office 48 hours prior to old well workover or re-entry.


5. Prior to plugging, prepare a plugging plan, then obtain agreement from the appropriate district office for an approved plugging plan.

6. Submit plugging report (CP-4) to K.C.C. after plugging is completed.

7. Obtain an approved injection docket number before disposing of salt water.

8. Notify K.C.C. within 10 days when injection commences or terminates.

9. If an alternate 2 completion, cement in the production pipe from below any usable water to surface within 120 days of spud date.

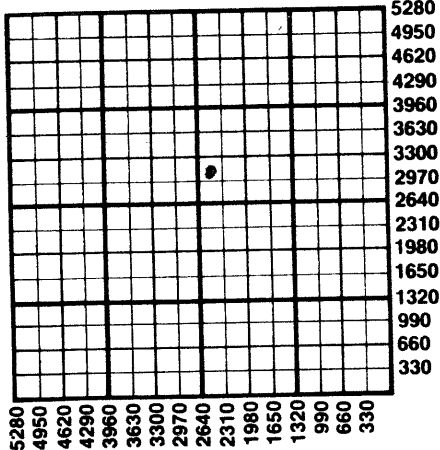

State Corporation Commission of Kansas
Conservation Division
200 Colorado Derby Building
Wichita, Kansas 67202
(316) 263-3238