

CARD MUST BE TYPED

State of Kansas

CARD MUST BE SIGNED

NOTICE OF INTENTION TO DRILL

(see rules on reverse side)

Starting Date March 18, 1986
month day year 3:30

API Number 15— 059-24159-00-00

OPERATOR: License # 9873

SE SW NE East

Name Painter Oil Company, Inc.

..... Sec... 29 Twp... 15 S, Rg... 20... West

Address Route 2, Box 141-B

..... 2970 Ft. from South Line of Section

City/State/Zip Wellsville, KS 66092

..... 1650 Ft. from East Line of Section

Contact Person Jerry Hardsaw

(Note: Locate well on Section Plat on reverse side)

Phone 913 242 7310

Nearest lease or unit boundary line 1650 feet

CONTRACTOR: License # 5666

County Franklin

Name Finchs Drilling, Inc.

Lease Name Allen Vick Well # 3 Inj.

City/State Route 2, Ottawa, KS 66067

Ground surface elevation feet MSL

Well Drilled For: Well Class: Type Equipment:

Domestic well within 330 feet: yes no

Oil SWD Infield Mud Rotary

Municipal well within one mile: yes no

Gas Inj Pool Ext. Air Rotary

Depth to bottom of fresh water 60

OWWO Expl Wildcat Cable

Depth to bottom of usable water 200

If OWWO: old well info as follows:

Surface pipe by Alternate: 1 2

Operator

Surface pipe planned to be set 40

Well Name

Conductor pipe required

Comp Date Old Total Depth

Projected Total Depth 790 feet

I certify that well will comply with K.S.A. 55-101, et seq., plus eventually plugging hole to KCC specifications.

Formation

Date 3/17/86 ... Signature of Operator or Agent *E. J. Barkman* Title as agent

For KCC Use:

Conductor Pipe Required feet; Minimum Surface Pipe Required ⁴⁰ feet per Alt. 4 ²


This Authorization Expires 2-18-86 Approved By 3-18-86 *[Signature]*

Must be filed with the K.C.C. five (5) days prior to commencing well
 This card void if drilling not started within six (6) months of date received by K.C.C.

Important procedures to follow:

1. Notify District office before setting surface casing.
2. Set surface casing by circulating cement to the top.
3. File completion forms ACO-1 with K.C.C. within 90 days of well completion, following instructions on ACO-1, side 1, and including copies of wireline logs.
4. Notify District office 48 hours prior to old well workover or re-entry.
5. Prior to filing Intent, prepare a proposed plugging plan in case well is D & A, then obtain approval of plan when calling district office prior to setting surface pipe.
6. Submit plugging report (CP-4) to K.C.C. after plugging is completed.
7. Obtain an approved injection docket number before disposing of salt water.
8. Notify K.C.C. within 10 days when injection commences or terminates.
9. If an alternate 2 completion, cement in the production pipe from below any usable water to surface within 120 days of spud date.

A Regular Section of Land
 1 Mile = 5,280 Ft.

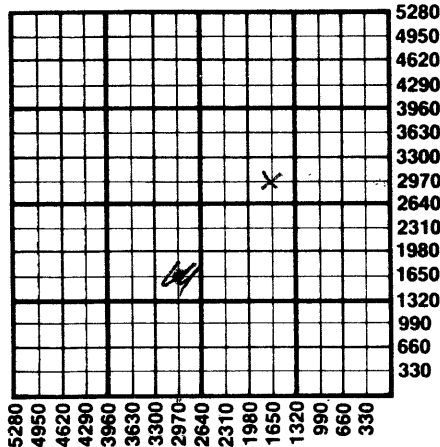

RECEIVED
 STATE CORPORATION COMMISSION

MAR 18 1986

3-18-86

State Corporation Commission of Kansas
 Conservation Division
 200 Colorado Derby Building
 Wichita, Kansas 67202
 (316) 263-3238