

CARD MUST BE TYPED

State of Kansas

CARD MUST BE SIGNED

NOTICE OF INTENTION TO DRILL

(see rules on reverse side)

Starting Date 12-30-86 month day year

API Number 15-059-24,193-00-00

OPERATOR: License # 7069 Hermreck Oil Co. Name Address 511 Terrace Trail East City/State/Zip Lake Quivira, K.C., KS 66106 Contact Person Arlo S. Hermreck Phone 913-268-9152

N.E. N.E. S.E. N.E. Sec. 29 Twp. 15 S, Rg. 20 East 3795 Ft. from South Line of Section 165 Ft. from East Line of Section

(Note: Locate well on Section Plat on reverse side)

CONTRACTOR: License # 5666 Finch's Drilling Inc. Name City/State Route 2, Box 125, Ottawa, KS 66067

Nearest lease or unit boundary line 165 feet County Franklin Lease Name Hermreck Lease Well # 1 Ground surface elevation feet MSL Domestic well within 330 feet yes no Municipal well within one mile yes no Surface pipe by Alternate: 1 2 X Depth to bottom of fresh water 20-30 feet Depth to bottom of usable water 200 feet Surface pipe planned to be set 50-80 feet Projected Total Depth 800 feet Formation Squirrel #1 & #2

Well Drilled For: Well Class: Type Equipment: X Oil SWD X Infield X Mud Rotary Gas Inj Pool Ext Air Rotary OWWO Expl Wildcat Cable

If OWWO: old well info as follows:

Operator Well Name Comp Date Old Total Depth

I certify that well will comply with K.S.A. 55-101, et seq., plus eventually plugging hole to KCC specifications.

Date 12-26-86 cementing will be done immediately upon setting production casing. Signature of Operator or Agent Arlo S. Hermreck Title Land Owner

For KCC Use:


Conductor Pipe Required feet; Minimum Surface Pipe Required feet per Alt. 20 feet per Alt. This Authorization Expires 6-30-87 Approved By 12-30-86

Must be filed with the K.C.C. five (5) days prior to commencing well
 This card void if drilling not started within six (6) months of date received by K.C.C.

Important procedures to follow:

1. Notify District office before setting surface casing.
2. Set surface casing by circulating cement to the top.
3. File completion forms ACO-1 with K.C.C. within 90 days of well completion, following instructions on ACO-1, side 1, and including copies of wireline logs.
4. Notify District office 48 hours prior to old well workover or re-entry.
5. Prior to filing Intent, prepare a proposed plugging plan in case well is D & A, then obtain approval of plan when calling district office prior to setting surface pipe.
6. Submit plugging report (CP-4) to K. C. C. after plugging is completed.
7. Obtain an approved injection docket number before disposing of salt water.
8. Notify K.C.C. within 10 days when injection commences or terminates.

A Regular Section of Land
1 Mile = 5,280 Ft.

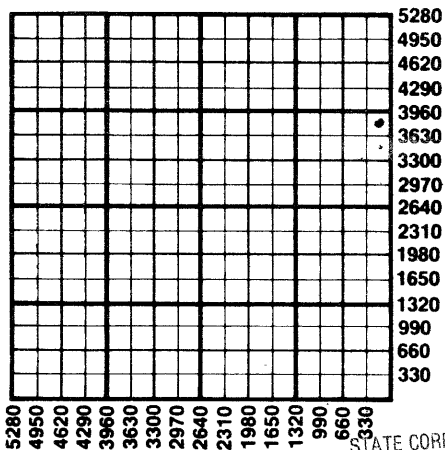

STATE CORPORATION COMMISSION

an alternate 2 completion, cement in the production pipe from below any usable water to surface within 120 days of spud date.

DEC 30 1983

CONSERVATION DIVISION
 Wichita, Kansas

12-30-86

State Corporation Commission of Kansas
 Conservation Division
 200 Colorado Derby Building
 Wichita, Kansas 67202
 (316) 263-3238