

15-179-30058-00-00

STATE OF KANSAS  
STATE CORPORATION COMMISSION

Form CP-4

WELL PLUGGING RECORD

Give All Information Completely  
Make Required Affidavit  
Mail or Deliver Report to:  
Conservation Division  
State Corporation Commission  
212 No. Market  
Wichita, Kansas

Sheridan County. Sec. 2 Twp. 7S Rge. 26 (E) W (W)

Location as "NE/CNW4SW4" or footage from lines. NE NE NE

Lease Owner Rock Island Oil & Refining Co., Inc.

Lease Name Davis Well No. 1

Office Address 321 West Douglas, Wichita, Kansas 67202

Character of Well (completed as Oil, Gas or Dry Hole) Dry Hole

Date well completed December 20 19 65

Application for plugging filed December 20 19 65

Application for plugging approved December 20 19 65


Plugging commenced December 20 19 65

Plugging completed December 20 19 65

Reason for abandonment of well or producing formation Dry hole

If a producing well is abandoned, date of last production 19

Was permission obtained from the Conservation Division or its agents before plugging was commenced? Yes

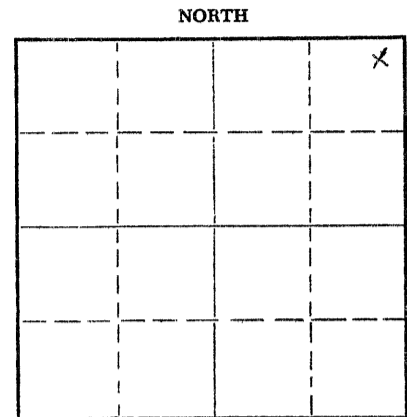

Locate well correctly on above Section Plat

Name of Conservation Agent who supervised plugging of this well W. L. Nichols

Producing formation \_\_\_\_\_ Depth to top \_\_\_\_\_ Bottom \_\_\_\_\_ Total Depth of Well 2900 Feet

Show depth and thickness of all water, oil and gas formations.

OIL, GAS OR WATER RECORDS

CASING RECORD

FORMATION	CONTENT	FROM	TO	SIZE	PUT IN	PULLED OUT
		0	290	7"	290	0

Describe in detail the manner in which the well was plugged, indicating where the mud fluid was placed and the method or methods used in introducing it into the hole. If cement or other plugs were used, state the character of same and depth placed, from \_\_\_\_\_ feet to \_\_\_\_\_ feet for each plug set.

Plugged with 15 sx cement @ 540';  
15 sx cement @ 275'; 10 sx cement  
@ 40' to surface.

RECEIVED  
STATE CORPORATION COMMISSION

JAN 3 1966

CONSERVATION DIVISION  
Wichita, Kansas

1-3-66

(If additional description is necessary, use BACK of this sheet)

Name of Plugging Contractor Paine Drilling Co., Inc.  
Address P. O. Box D, Hill City, Kansas

STATE OF Kansas, COUNTY OF Graham, ss.  
D. F. McCarthy (employee of owner or operator) of the above-described

well, being first duly sworn on oath, says: That I have knowledge of the facts, statements, and matters herein contained and the log of the above-described well as filed and that the same are true and correct. So help me God.

(Signature) *D. F. McCarthy*

P. O. Box D, Hill City, Kansas  
(Address)

SUBSCRIBED AND SWORN TO before me this 30th day of December, 19 65

My Commission Expires January 20, 1966

My commission expires \_\_\_\_\_

*Cara S. Miller*

Notary Public.

CONTRACTOR'S WELL LOG

COMPANY: Rock Island Oil & Refining Co., Inc.  
 CONTRACTOR: Paine Drilling Co., Inc.  
 WELL: Davis # 1  
 LOCATION: NE NE NE Section 2-78-26W  
 Sheridan County, Kansas  
 COMMENCED: December 17, 1965  
 COMPLETED: December 20, 1965

0	90	Clay
90	205	Sand & Gravel
205	291	Blue Shale
291	2241	Shale & Sand
2241	2277	Anhydrite
2277	2740	Shale
2740	2900	Shale & Lime
2900		Rotary Total Depth

RECEIVED  
 STATE CORPORATION COMMISSION  
 JAN 3 1965  
 1-3-66  
 CONSERVATION DIVISION  

Set 7 inch surface pipe @ 290 feet with 175 sx cement.

DRY & ABANDONED

We hereby certify that the above is a correct and accurate log of the above mentioned well, as shown on the daily drilling reports.

PAINE DRILLING CO., INC.

By: *D. F. McCarthy*  
 Treasurer

Subscribed and sworn to before me this 30th day of December, 1965.

*Con. Seiler*

My Commission Expires January 20, 1966