

15-179-00116-00-00


STATE OF KANSAS
STATE CORPORATION COMMISSION

WELL PLUGGING RECORD

Give All Information Completely
Make Required Affidavit
Mail or Deliver Report to:
Conservation Division
State Corporation Commission
800 Biting Building
Wichita, Kansas

SHERIDAN County. Sec. 3 Twp. 7 Rge. 26 (E) W (W)

NORTH

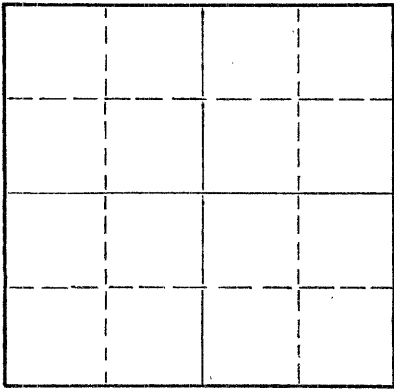

Locate well correctly on above
Section Plat

Location as "NE/CNW/SW" or footage from lines SW SW SW
Lease Owner EMPIRE DRILLING COMPANY
Lease Name O. S. ALLEN Well No. 1
Office Address 407 BROWN BUILDING, WICHITA 2, KANSAS
Character of Well (completed as Oil, Gas or Dry Hole) DRY HOLE
Date well completed MARCH 15 1955
Application for plugging filed MARCH 15 1955
Application for plugging approved MARCH 15 1955
Plugging commenced MARCH 15 1955
Plugging completed MARCH 15 1955
Reason for abandonment of well or producing formation DRY HOLE

If a producing well is abandoned, date of last production 19____
Was permission obtained from the Conservation Division or its agents before plugging was commenced? YES

Name of Conservation Agent who supervised plugging of this well ELDON PETTY
Producing formation _____ Depth to top _____ Bottom _____ Total Depth of Well 4011 Feet
Show depth and thickness of all water, oil and gas formations.

OIL, GAS OR WATER RECORDS

CASING RECORD

FORMATION	CONTENT	FROM	TO	SIZE	PUT IN	PULLED OUT
SURFACE		0	324'	8 5/8"	324'	0

Describe in detail the manner in which the well was plugged, indicating where the mud fluid was placed and the method or methods used in introducing it into the hole. If cement or other plugs were used, state the character of same and depth placed, from _____ feet to _____ feet for each plug set.

FIRST PLUG SET AT 315' WITH 1/2 SACK HULLS AND 15 SACKS OF CEMENT.

TOP PLUG SET AT 40' WITH 1/2 SACK HULLS AND 10 SACKS OF CEMENT.

RECEIVED

(If additional description is necessary, use BACK of this sheet)

Name of Plugging Contractor EMPIRE DRILLING COMPANY
Address 407 BROWN BUILDING, WICHITA 2, KANSAS

3-22-55

STATE OF KANSAS, COUNTY OF SEDGWICK, ss.
I, DAN J. KORNFELD

(owner or operator) of the above-described well, being first duly sworn on oath, says: That I have knowledge of the facts, statements, and matters herein contained and the log of the above-described well as filed and that the same are true and correct. So help me God.

(Signature) DAN J. KORNFELD
407 BROWN BUILDING, WICHITA 2, KANSAS
(Address)

SUBSCRIBED AND SWORN to before me this 18TH day of MARCH, 19 55

[Signature of Notary Public]

My commission expires DECEMBER 10, 1956

Notary Public.

PLUGGING
FILE SEC 3 T 7 R 26W
BOOK PAGE 105 LINE 23

LOG

COMPANY: R. W. SHIELDS AND
EMPIRE DRILLING COMPANY

CONTRACTOR: EMPIRE DRILLING COMPANY

FARM: O. S. ALLEN #1

LOCATION: SW SW SW, SEC. 3-7-26W
SHERIDAN COUNTY, KANSAS

COMMENCED: 3-6-55

COMPLETED: 3-15-55

0	TO	40	CLAY
40	TO	340	SAND AND SHALE
340	TO	730	SHALE
730	TO	2170	SHALE AND SAND
2170	TO	2276	SHALE AND SHELLS
2276	TO	2311	ANHYDRITE
2311	TO	2820	SHALE AND SHELLS
2820	TO	2955	SHALE AND LIME STREAKS
2955	TO	3075	SHALE AND LIME
3075	TO	3165	LIME
3165	TO	3835	LIME AND SHALE
3835	TO	3960	LIME
3960	TO	4011	LIME AND SHALE
4011			R.T.D.

SET 324' OF 8 5/8" SURFACE CASING, CEMENTED WITH 150 SACKS OF CEMENT.

ELEVATION: 2590 K.B.

TOPS: ANHYDRITE 2276'; HEEBNER 3753'; TORONTO 3777'; LANSING 3796'; BASE K.C. 3999';
R.T.D. 4011.

D & A


C E R T I F I C A T I O N

I, DAN J. KORNFELD, DO HEREBY CERTIFY THAT THE ABOVE AND FOREGOING IS A TRUE AND CORRECT COPY OF THE LOG ON THE O. S. ALLEN #1, SW SW SW, SECTION 3, TOWNSHIP 3, RANGE 26 WEST, SHERIDAN COUNTY, KANSAS, AS REFLECTED BY THE FILES OF THE EMPIRE DRILLING COMPANY.


DAN J. KORNFELD

SUBSCRIBED AND SWORN TO BEFORE ME A NOTARY PUBLIC WITHIN AND FOR SEDGWICK COUNTY, KANSAS
THIS 18TH DAY OF MARCH, 1955.

MY COMMISSION EXPIRES DECEMBER 10, 1956

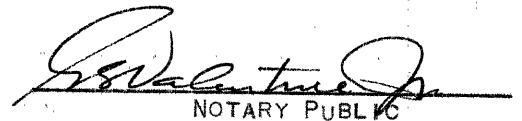
NOTARY PUBLIC

3-22-55

