


STATE OF KANSAS  
STATE CORPORATION COMMISSION  
Give All Information Completely  
Make Required Affidavit  
Mail or Deliver Report to:  
Conservation Division  
State Corporation Commission  
211 No. Broadway  
Wichita, Kansas

WELL PLUGGING RECORD

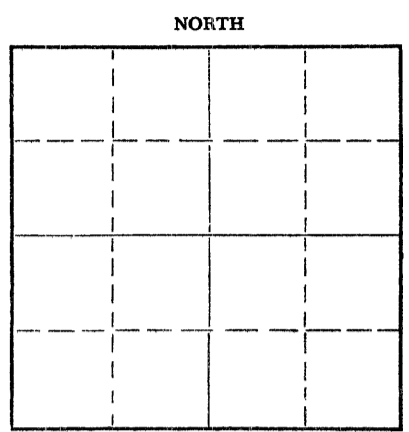

Locate well correctly on above Section Plat

Graham County, Sec. 36 Twp. 7S Rge. 25W (E) (W)  
Location as "NE/CNW/SW" or footage from lines C NW NE  
Lease Owner Okmar Oil Company  
Lease Name Moore Well No. 1  
Office Address 1130 Wichita Plaza, Wichita, Kansas 67202  
Character of Well (completed as Oil, Gas or Dry Hole) Dry Hole  
Date well completed 9-21-65 19  
Application for plugging filed 9-21-65 19  
Application for plugging approved 9-21-65 19  
Plugging commenced 9-21-65 19  
Plugging completed 9-21-65 19  
Reason for abandonment of well or producing formation Dry Hole

If a producing well is abandoned, date of last production 19  
Was permission obtained from the Conservation Division or its agents before plugging was commenced? yes

Name of Conservation Agent who supervised plugging of this well W. L. Nichols, Moreland, Ks.  
Producing formation \_\_\_\_\_ Depth to top \_\_\_\_\_ Bottom \_\_\_\_\_ Total Depth of Well 4000 Feet  
Show depth and thickness of all water, oil and gas formations.

OIL, GAS OR WATER RECORDS

CASING RECORD

FORMATION	CONTENT	FROM	TO	SIZE	PUT IN	PULLED OUT
				8 5/8"	219'	none

Describe in detail the manner in which the well was plugged, indicating where the mud fluid was placed and the method or methods used in introducing it into the hole. If cement or other plugs were used, state the character of same and depth placed, from \_\_\_\_\_ feet to \_\_\_\_\_ feet for each plug set.

Mud to 550', plug, 20 sacks cement  
Mud to 210', plug, 1/2 sk. hulls, 20 sacks cement  
Mud to 40', 1/2 sk. hulls, plug, 10 sks. cement

RECEIVED  
STATE CORPORATION COMMISSION  
SEP 27 1965  
SEP 27 1965  
CONSERVATION DIVISION  
Wichita, Kansas

(If additional description is necessary, use BACK of this sheet)

Name of Plugging Contractor Leben Drilling, Inc.  
Address Box 486, Great Bend, Kansas

STATE OF KANSAS, COUNTY OF BARTON, ss.  
Leslie Kite (employee of owner) or (owner or operator) of the above-described well, being first duly sworn on oath, says: That I have knowledge of the facts, statements, and matters herein contained and the log of the above-described well as filed and that the same are true and correct. So help me God.

(Signature) Leslie Kite

P. O. Box 486, Great Bend, Kansas (Address)

SUBSCRIBED AND SWORN TO before me this 24th day of September, 1965

My commission expires April 1, 1967  
Wanda Nichols Notary Public.

DRILLER'S LOG

COMPANY: Okmar Oil Company  
 CONTRACTOR: LEBEN DRILLING, INC.  
 FARM: MOORE #1  
 LOCATION: C NW NE Sec. 36-7S-25W  
 GRAHAM COUNTY, KANSAS  
 COMMENCED: 9-13-65  
 COMPLETED: 9-21-65

0	60	Surface soil, sand
60	110	Shale
110	120	Sand
120	219	Post Rock, Shale
219	1065	Shale
1065	1785	Sand, Shale
1785	2187	Redbed, Shale
2187	2221	Anhydrite
2221	2285	Shale
2285	2590	Shale, Shells
2590	3090	Shale, Lime
3090	3575	Lime, Shale
3575	4000	Lime
	<u>4000</u>	<u>RTD - D. &amp; A.</u>

**RECEIVED**  
 STATE CORPORATION COMMISSION

SEP 27 1965  
 SEP 27, 1965  
 CONSERVATION DIVISION  
 Wichita, Kansas

Set 8 5/8" used surface casing @ 219' with 175 sacks Sunset 2% Gel cement did not circulate, cement through 2" pipe with approximately 80 sacks cement to cellar

I, Leslie Kite, do hereby certify that the above and foregoing is a true and correct copy of the log of the Moore #1 well, located C NW NE Section 36, Township 7 South, Range 25 West, Graham County, Kansas, as reflected by the records of Leben Drilling, Inc.

*Leslie Kite*

Leslie Kite

STATE OF KANSAS )  
 ) SS  
 COUNTY OF BARTON)

Subscribed and sworn to before me, a Notary Public, in and for Barton County, Kansas, this 24th day of September, 1965.

*Ulanda Nichols*

Ulanda Nichols

My Commission Expires:  
 April 1, 1967