


STATE OF KANSAS
STATE CORPORATION COMMISSION

13-179-05628-00-00

Give All Information Completely
Make Required Affidavit
Mail or Deliver Report to:
Conservation Division
State Corporation Commission
800 Bitting Building
Wichita, Kansas

WELL PLUGGING RECORD

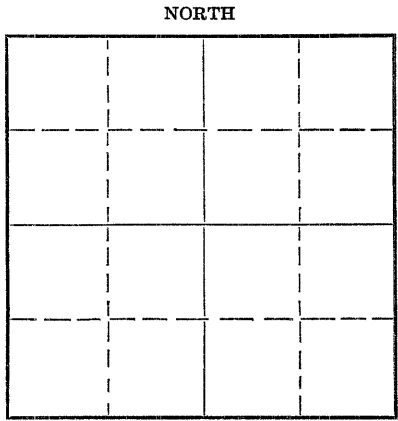

Sheridan County. Sec. 5 Twp. 7 S Rge. (E) 26 (W)
Location as "NE/CNW $\frac{1}{4}$ SW $\frac{1}{4}$ " or footage from lines NW NW SE
Lease Owner Herndon Drilling Company
Lease Name Barnett Well No. 1
Office Address P.O. Drawer 489, Tulsa, Oklahoma
Character of Well (completed as Oil, Gas or Dry Hole) Dry
Date well completed April 6 19 52
Application for plugging filed April 6 19 52
Application for plugging approved April 6 19 52
Plugging commenced April 7 - 8:00 A.M. 19 52
Plugging completed April 7 - 11:00 A.M. 19 52
Reason for abandonment of well or producing formation Dry

Locate well correctly on above Section Plat

Name of Conservation Agent who supervised plugging of this well Eldon Petty
Producing formation Depth to top Bottom Total Depth of Well 4523 Feet
Show depth and thickness of all water, oil and gas formations.

OIL, GAS OR WATER RECORDS

CASING RECORD

Formation	Content	From	To	Size	Put In	Pulled Out
		Surface	283'	8-5/8	283'	None

Describe in detail the manner in which the well was plugged, indicating where the mud fluid was placed and the method or methods used in introducing it into the hole. If cement or other plugs were used, state the character of same and depth placed, from feet to feet for each plug set.

Filled hole with mud to 270'. Pushed plug to 270'. Put 1/2 sack of hulls on top of plug. Mixed 15 sacks of cement put on top plug. Filled hole to 40' with mud. Pushed plug to 40'. Put 1/2 sack of hulls on top of plug. Mixed 10 sacks of cement and filled hole with same. Hole was filled with cement. 8-5/8" casing cut off 4' below ground level and cap welded over it.

(If additional description is necessary, use BACK of this sheet)
Name of Plugging Contractor Herndon Drilling Company
Address 423 Mayo Building, Tulsa, Oklahoma

STATE OF Oklahoma, COUNTY OF Tulsa, ss.
Jack Herndon (employee of owner) or (owner or operator) of the above-described well,
being first duly sworn on oath, says: That I have knowledge of the facts, statements, and matters herein contained and the log of the above-described well as filed and that the same are true and correct. So help me God.

(Signature) *Jack Herndon*

SUBSCRIBED AND SWORN to before me this 15th day of April, 19 52

My commission expires Sept. 19, 1952 Notary Public.

23-8390-s 6-51-20M
PLUGGING
FILE SEC 5 T 7 R 26W
BOOK PAGE 7 LINE 44

4-16-52

15-179-05628-0000

WELL LOG ON BARNETT # 1

Spudding date: 3/16/52
Date casing set: Plugged: 4/7/52
Date rotary completed: 4/6/52
Date cable completed:

Location:
Section 5-7S-26W, Sheridan
County, Kansas

FROM	TO	FORMATION	REMARKS
0	13	Surface	Ran 9 jts of 8-5/8" csg. Set @ 283'. Cemented w/200 sx. of cement.
13	283	Sand & shale	
283	340	Shale	
340	950	Sand & shale	
950	2665	Shale & shells	
2665	2800	Sandy Lime & shale	
2800	4026	Lime	
4026	4035	Sand	
4035	4105	Lime & shale	
4105	4240	Lime	
4240	4285	Lime & shale	
4285	4401	Lime & chert	
4401	4405	Lime	
4405	4454	Lime & shale	
4454	4501	Lime	
4501	4523	Lime & sand	
4523		TOTAL DEPTH	Filled hole with mud to 270' Pushed plug to 270' Put 1/2 sack of hulls on top of plug. Filled hole to 40' with mud. Pushed plug to 40' Put 1/2 sack of hulls on top of plug. Mixed 10 sacks of cement & filled hole with same. Hole was filled with cement. 8-5/8" csg. cut off 4" below ground level & cap welded over it.

4-16-52

Subscribed and sworn to before me this 11th
day of April, 19 52

I certify the above and foregoing to be a true and exact
copy of the original driller's log on the BARNETT #1

Clarence Sturgeon
Notary Public
My commission expires:

HERNDON DRILLING COMPANY
By: *C. J. Moore*
Title:

My commission expires Aug. 28, 1955

PLUGGING
FILE SEC 517 R 26D
BOOK PAGE 7 LINE 44