

15-179-00081-00-00

STATE OF KANSAS
STATE CORPORATION COMMISSION


Give All Information Completely
Make Required Affidavit
Mail or Deliver Report to:
Conservation Division
State Corporation Commission
800 Bittig Building
Wichita, Kansas

WELL PLUGGING RECORD

Sheridan County, Sec. 10 Twp. 7 Rge. 26 (E) (W)

Location as "NE/CNW/SW" or footage from lines NE NW SE
Lease Owner National Cooperative Refinery Association
Lease Name Teagarden Well No. 1
Office Address 305 Rule Building, Wichita, Kansas
Character of Well (completed as Oil, Gas or Dry Hole) Dry Hole
Date well completed April 10, 1954
Application for plugging filed April 13, 1954
Application for plugging approved April 12, 1954
Plugging commenced April 10, 1954
Plugging completed April 10, 1954
Reason for abandonment of well or producing formation Dry Hole

NORTH

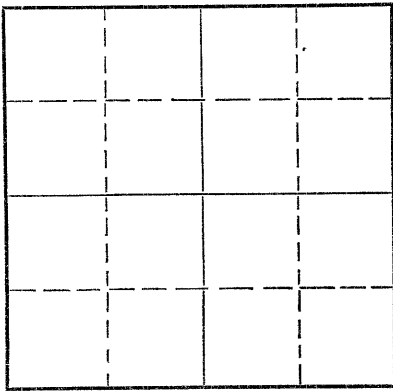

Locate well correctly on above
Section Plat

If a producing well is abandoned, date of last production 19
Was permission obtained from the Conservation Division or its agents before plugging was commenced? Yes

Name of Conservation Agent who supervised plugging of this well Eldon Petty
Producing formation _____ Depth to top _____ Bottom _____ Total Depth of Well 4360 Feet
Show depth and thickness of all water, oil and gas formations.

OIL, GAS OR WATER RECORDS

CASING RECORD

FORMATION	CONTENT	FROM	TO	SIZE	PUT IN	PULLED OUT
				8 5/8"	315'	None-cemented

Describe in detail the manner in which the well was plugged, indicating where the mud fluid was placed and the method or methods used in introducing it into the hole. If cement or other plugs were used, state the character of same and depth placed, from _____ feet to _____ feet for each plug set.

Mudded hole to 300', set plug with one-half sack huss plus 15 sacks of cement.
Mudded hole to 40', set plug with one-half sack of hulls plus 10 sacks cement on up to base of cellar.

(If additional description is necessary, use BACK of this sheet)

Name of Plugging Contractor Murfin Drilling Company
Address 910 Union National Bank Building, Wichita, Kansas

STATE OF Kansas, COUNTY OF Sedgwick, ss.
C. R. Sears (employee of owner) or (owner or operator) of the above-described well, being first duly sworn on oath, says: That I have knowledge of the facts, statements, and matters herein contained and the log of the above-described well as filed and that the same are true and correct. So help me God.

(Signature) C. R. Sears


305 Rule Building, Wichita, Kansas
(Address)

SUBSCRIBED AND SWORN TO before me this 15th day of April, 1954

My commission expires June 30, 1954

C. Orville May
Notary Public.

24-7368-S 3-53-20M

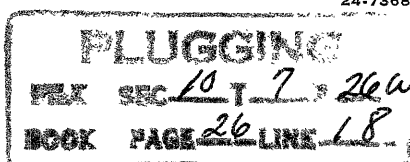

4-16-54