


STATE OF KANSAS
STATE CORPORATION COMMISSION

15-179-00193-00-00

Give All Information Completely
Make Required Affidavit
Mail or Deliver Report to:
Conservation Division
State Corporation Commission
211 No. Broadway
Wichita, Kansas

WELL PLUGGING RECORD

NORTH

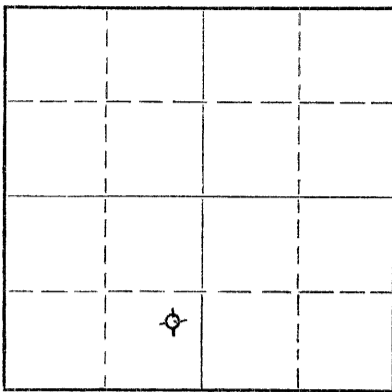

Locate well correctly on above
Section Plat

Sheridan County. Sec. 12 Twp. 7S Rge. 26W (E) (W)
Location as "NE/CNW/SW" or footage from lines NE SE SW
Lease Owner C-G Drilling Co. & N. Appleman Co.
Lease Name Mowry Well No. 1
Office Address 107 Rule Building, Wichita, Kansas
Character of Well (completed as Oil, Gas or Dry Hole) Dry Hole
Date well completed July 13 1957
Application for plugging filed July 13 1957
Application for plugging approved July 13 1957
Plugging commenced July 14 1957
Plugging completed July 14 1957
Reason for abandonment of well or producing formation Too low structurally

If a producing well is abandoned, date of last production _____ 19____
Was permission obtained from the Conservation Division or its agents before plugging was commenced? Yes

Name of Conservation Agent who supervised plugging of this well Eldon Petty, Hays, Kansas
Producing formation _____ Depth to top _____ Bottom _____ Total Depth of Well 4051 Feet
Show depth and thickness of all water, oil and gas formations.

OIL, GAS OR WATER RECORDS

CASING RECORD

FORMATION	CONTENT	FROM	TO	SIZE	PUT IN	PULLED OUT
				8-5/8"	272'	none

Describe in detail the manner in which the well was plugged, indicating where the mud fluid was placed and the method or methods used in introducing it into the hole. If cement or other plugs were used, state the character of same and depth placed, from _____ feet to _____ feet for each plug set.

Filled hole with heavy mud to 265'. Set plug. Put in 1/2 sack hulls and 20 sacks cement. Filled with heavy mud up to 40'. Set plug. Filled to top with 1/2 sack hulls and 10 sacks cement.

(If additional description is necessary, use BACK of this sheet)

Name of Plugging Contractor C-G Drilling Co.
Address 107 Rule Building, Wichita, Kansas

STATE OF KANSAS, COUNTY OF SEDGWICK, ss.
Jay H. Galloway (employee of owner) or (owner or operator) of the above-described well, being first duly sworn on oath, says: That I have knowledge of the facts, statements, and matters herein contained and the log of the above-described well as filed and that the same are true and correct. So help me God.

(Signature) Jay H. Galloway
107 Rule Bldg.
(Address)

SUBSCRIBED AND SWORN TO before me this 17th day of July, 1957

My commission expires May 20, 1959

Vicky Jacobs
Vicky Jacobs Notary Public.

PLUGGING
FILE SEC. 12 T. 7 R. 26W
BOOK PAGE 28 OF 28

RECEIVED
STATE CORPORATION COMMISSION
JUL 18 1957
7-18-57
CONSERVATION DIVISION
Wichita, Kansas

19-179-00193-00-00

CONTRACTOR'S WELL LOG

OPERATOR C-G Drilling Co. & N. Appleman Co. WELL NAME Mowry #1
 LOCATION NE SE SW Sec. 12-7S-26W RIG NO. 1
 COUNTY Sheridan STATE Kansas
 COMMENCEMENT DATE July 5, 1957 COMPLETION DATE July 13, 1957

LOG OF WELL

Elevation 2577' rotary bushing.
 All measurements taken from the top of rotary bushing.

FROM	TO	FORMATION	DEVIATION FROM VERTICAL	REMARKS:
0	272	Surface Soil		
272	800	Sand-Shale		
800	1600	Sand-Shale		
1600	1660	Shale		
1660	1875	Sand-Shale		
1875	1975	Sand		
1975	2255	Sand-Red Bed-Shale		
2255	2294	Anhydrite		
2294	2440	Shale		
2440	2675	Lime-Shale	0° - 2500	
2675	2850	Lime-Shale	0° - 2750	
2850	2990	Lime-Shale		
2990	3165	Lime-Shale	0° - 3000	
3165	3240	Lime-Shale		
3240	3340	Lime-Shale	0° - 3250	6
3340	3485	Lime-Shale		
3485	3535	Lime-Shale	0° - 3500	
3535	3635	Lime-Shale		
3635	3785	Lime-Shale	0° - 3750	
3785	3875	Lime-Shale		
3875	4051	Lime	0° - 4000	

CASING LEFT IN HOLE AFTER COMPLETION

Ran 272' (14 jts.) of 8-5/8" OD Surface Casing.

STATE OF KANSAS }
 COUNTY OF SEDGWICK } SS.

The undersigned hereby certifies that to the best of his knowledge and belief, the above facts are true and correct.

C-G DRILLING CO.
 By Jay H. Galloway
 Jay H. Galloway

Subscribed and sworn to before me this 17th day of July, 1957.

Vicky Jacobs
 Vicky Jacobs, Notary Public

My commission expires: May 20, 1959

RECEIVED
 STATE CONSERVATION COMMISSION
 7-18-57
 JUL 18 1957
 CONSERVATION DIVISION
 Wichita, Kansas

PLUGGING
 FILE SEC 12 T 7 R 26W
 BOOK PAGE 28 LINE 28