

15-179-20270-00-00

STATE OF KANSAS
STATE CORPORATION COMMISSION

Form CP-4

Give All Information Completely
Make Required Affidavit
Mail or Deliver Report to:
Conservation Division
State Corporation Commission
212 No. Market
Wichita, Kansas 67202

WELL PLUGGING RECORD

Sheridan County, Sec. 12 Twp. 7S Rge. (E) 26 (W)

Location as "NE/CNW/SW" or footage from lines SE-SW-NE

Lease Owner Aspen Resources, Ltd.

Lease Name Heskett Well No. 1

Office Address 710 One-Twenty Building, Wichita, Kansas

Character of Well (completed as Oil, Gas or Dry Hole) Dry Hole

Date well completed October 3 19 70

Application for plugging filed October 5 19 70

Application for plugging approved 19


Plugging commenced October 3 19 70

Plugging completed same 19

Reason for abandonment of well or producing formation Dry hole

If a producing well is abandoned, date of last production 19

Was permission obtained from the Conservation Division or its agents before plugging was commenced? yes

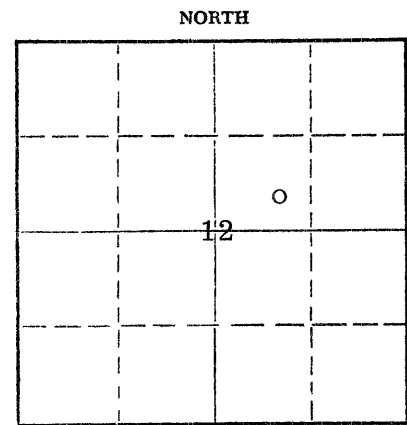

Locate well correctly on above
Section Plat

Name of Conservation Agent who supervised plugging of this well W. L. Nichols, Morland, Kansas

Producing formation Depth to top Bottom Total Depth of Well 3880 Feet

Show depth and thickness of all water, oil and gas formations.

OIL, GAS OR WATER RECORDS

CASING RECORD

FORMATION	CONTENT	FROM	TO	SIZE	PUT IN	PULLED OUT

Describe in detail the manner in which the well was plugged, indicating where the mud fluid was placed and the method or methods used in introducing it into the hole. If cement or other plugs were used, state the character of same and depth placed, from feet to feet for each plug set.

Plug at 1325' with 100 cu. ft. cement;
plug at 310', 25 cu. ft. cement;
plug at 40', 10 cu. ft. cement.

RECEIVED
STATE CORPORATION COMMISSION
OCT 8 1970
CONSERVATION DIVISION
Wichita, Kansas

10-8-70

(If additional description is necessary, use BACK of this sheet)

Name of Plugging Contractor Aspen Drilling Co.

Address P. O. Box 783, Great Bend, Kansas

STATE OF Kansas, COUNTY OF Barton, ss.

William S. Schachle (employee of owner) or (owner or operator) of the above-described

well, being first duly sworn on oath, says: That I have knowledge of the facts, statements, and matters herein contained and the log of the above-described well as filed and that the same are true and correct. So help me God.

(Signature) William S. Schachle

William S. Schachle, Great Bend, Ks.

(Address)

SUBSCRIBED AND SWORN to before me this 5th day of October, 19 70

Theora Holleman
Notary Public.

My commission expires April 18, 1972

DRILLERS LOG

COMPANY: Aspen Resources, Ltd.
 CONTRACTOR: Aspen Drilling Co.
 LEASE NAME: Heskett #1
 LOCATION: SE-SW-NE Sec. 12-T7S-R26W
 Sheridan County, Kansas
 ELEVATION: 2543 K. B.
 SURFACE CASING: 7 jts. (283') 8 5/8"
 COMMENCED: September 26, 1970
 COMPLETED: October 3, 1970
 ROTARY TOTAL DEPTH: 3880'

<u>FORMATION</u>	<u>DEPTH</u>	
Sand & Shale	294	Ran 7 jts. (283') 8 5/8" casing
Shale & Shells	1655	set at 290' w/225 sacks. Cement
Shale & Lime	2120	circulated.
Shale	2153	
Anhydrite	2186	DST #1 3696-3722
Shale	2345	DST #2 3816-3838
Shale & Shells	2680	
Shale & Lime	3636	Ran electric log.
Lime	3880	D & A

AFFIDAVIT

State of Kansas)
) ss:
 County of Barton)


RECEIVED
 STATE CORPORATION COMMISSION
 OCT 8 1970
 CONSERVATION DIVISION
 Wichita, Kansas

10-8-70

The undersigned, being duly sworn on oath, states that the above statement and log are a true and correct record and log of the well drilled at the location above described.

William S. Schachle
 William S. Schachle, AFFIANT

Subscribed and sworn to before me this 6th day of October, 1970.

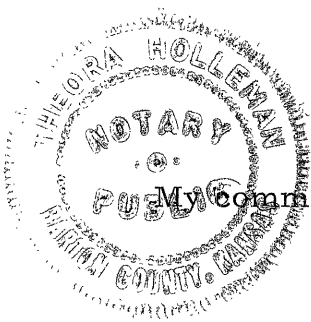

Theora Holleman
 Theora Holleman, Notary Public

My commission expires: April 18, 1972.