


15-179-00080-00-00

Give All Information Completely
Make Required Affidavit
Mail or Deliver Report to:
Conservation Division
State Corporation Commission
211 No. Broadway
Wichita, Kansas

WELL PLUGGING RECORD

NORTH

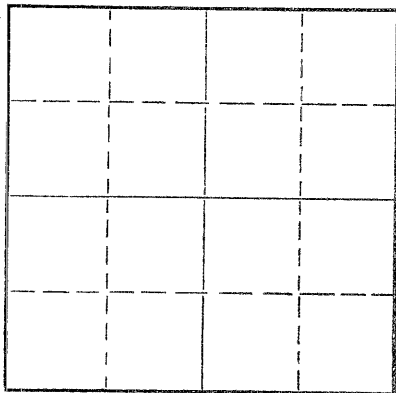

Locate well correctly on above
Section Plat

Sheridan County. Sec. 20 Twp. 7S Rge. 26W (X) (W)
Location as "NE/CNW/SW" or footage from lines NW 1/4 NW 1/4 NW 1/4
Lease Owner: Leben Drilling, Inc.
Lease Name: Shepherd Well No. 1
Office Address: 905 Central Bldg., Wichita, Kansas
Character of Well (completed as Oil, Gas or Dry Hole) Dry Hole
Date well completed June 7, 1958 19
Application for plugging filed 6-7-58 19
Application for plugging approved 6-7-58 19
Plugging commenced 6-7-58 19
Plugging completed 6-7-58 19
Reason for abandonment of well or producing formation Dry Hole

If a producing well is abandoned, date of last production _____ 19
Was permission obtained from the Conservation Division or its agents before plugging was commenced? yes

Name of Conservation Agent who supervised plugging of this well Fabricius
Producing formation _____ Depth to top _____ Bottom _____ Total Depth of Well 4062 Feet
Show depth and thickness of all water, oil and gas formations.

OIL, GAS OR WATER RECORDS

CASING RECORD

FORMATION	CONTENT	FROM	TO	SIZE	PUT IN	PULLED OUT
				8 5/8"	296'	

Describe in detail the manner in which the well was plugged, indicating where the mud fluid was placed and the method or methods used in introducing it into the hole. If cement or other plugs were used, state the character of same and depth placed, from _____ feet to _____ feet for each plug set.

1st Plug @ 600' with 25 sacks cement
2nd Plug @ 290' with 15 sacks cement
Top plug @ 40' with 10 sacks cement

6-20-58

(If additional description is necessary, use BACK of this sheet)
Name of Plugging Contractor: Leben Drilling, Inc.
Address: 905 Central Bldg., Wichita, Kansas

STATE OF Kansas COUNTY OF Sedgwick, ss.
I, Frank Hamlin (employee of owner) or (owner or operator) of the above-described well, being first duly sworn on oath, says: That I have knowledge of the facts, statements, and matters herein contained and the log of the above-described well as filed and that the same are true and correct. So help me God.

(Signature) Frank Hamlin
905 Central Bldg., Wichita, Kansas (Address)

SUBSCRIBED AND SWORN TO before me this 7th day of June, 19 58

My commission expires June 17, 1958
Ruth N. Benjamin Notary Public.

PLUGGING
FILE SEC 20 T 7 R 26W
BOOK PAGE 107 LINE 34

15-179-00080-00-00

DRILLER'S LOG

Sta. 11

COMPANY:
CONTRACTOR:
FARM:
LOCATION:

LEBEN DRILLING, INC.
LEBEN DRILLING, INC.
SHEPHERD #1
1/4 1/4 1/4 Sec. 20-75-26W
SHERIDAN COUNTY, KANSAS
COMMENCED:
COMPLETED:

COMMENCED:
COMPLETED:

0	210	Surface Sand & Clay		
210	226	Shale & sand stks.		
226	287	Sand & blue shale		
287	600	Sandy shale	TOPS:	
600	1375	Shale & Sand	Anhydrite	2300
1375	1520	Shale & Shells	Hosbner	3755
1520	1770	Sand & Shale	Toronto	3820
1770	1850	Shale & Lime	Lansing	3840
1850	2010	Redbed & Shale	Os. K.C.	4045
2010	2120	Shale & Sand		
2120	2300	Shale & Redbed	Elevation	2513 K.S.
2300	2335	Anhydrite		
2335	2615	Shale & Shells		
2615	3250	Shale & Lime		
3250	3495	Lime & Shale		
3495	3765	Lime & Shale		
3765	4062	Lime & Shale		
	4062	Rotary Total Depth - R & A		

Set 296' of 8 5/8" surface casing with 200 sacks cement & 4 sacks CaCl.

I, Frank Hamlin, do hereby certify that the above and foregoing is a true and correct copy of the log of the Shepherd #1, located 1/4 1/4 1/4 Section 20, Township 7 South, Range 26 West, Sheridan County, Kansas, as reflected by the files of Leben Drilling, Inc.

LEBEN DRILLING, INC.

By: Frank Hamlin
Frank Hamlin

State of Kansas }
County of Sedgwick } SS:

Subscribed and sworn to before me, a Notary Public, in and for Sedgwick County, Kansas, this 10th day of June, 1958

Ralph N. Benjamin
Ralph N. Benjamin, Notary Public

My Commission Expires:
June 17, 1961

6-20-58

JUN 2 1958

PLUGGING

FILE SEC. 20 T. 7 R. 26W

BOOK PAGE 107 LINE 34