

**STATE OF KANSAS  
STATE CORPORATION COMMISSION**  
Give All Information Completely  
Make Required Affidavit  
Mail or Deliver Report to:  
Conservation Division  
State Corporation Commission  
800 Bitting Building  
Wichita, Kansas

OR  
**FORMATION PLUGGING RECORD**

Strike out upper line when reporting plugging off formations.

Sheridan County. Sec. 21 Twp. 7 Rge. 26 (W) (W)

Location as "NE¼NW¼SW¼" or footage from lines. NE NE SW

Lease Owner. Anschutz & Polcyn

Lease Name. H. E. Webb Well No. 1

Office Address. Russell, Kansas

Character of Well (completed as Oil, Gas or Dry Hole) Dry Hole

Date well completed no log filed - not available 19.....


Application for plugging filed..... 19.....

Application for plugging approved..... January 18 19 46

Plugging commenced..... January 18, 19 46

Plugging completed..... January 9, 19 46

Reason for abandonment of well or producing formation. Dry Hole

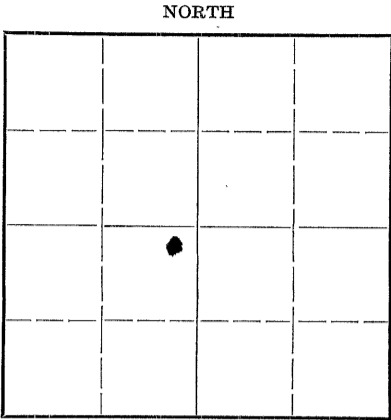

Locate well correctly on above Section Plat

If a producing well is abandoned, date of last production..... 19.....

Was permission obtained from the Conservation Division or its agents before plugging was commenced?..... Yes

Name of Conservation Agent who supervised plugging of this well..... H. W. Kerr

Producing formation..... Depth to top..... Bottom..... Total Depth of Well. 4562 Feet

Show depth and thickness of all water, oil and gas formations.

**OIL, GAS OR WATER RECORDS**

**CASING RECORD**

Formation	Content	From	To	Size	Put In	Pulled Out

Describe in detail the manner in which the well was plugged, indicating where the mud fluid was placed and the method or methods used in introducing it into the hold. If cement or other plugs were used, state the character of same and depth placed, from..... feet to..... feet for each plug set.

The hole was filled with heavy mud from 4562 feet to 300 feet. Cement bridge from 300 feet to 255 feet with 15 sacks cement. Heavy mud from 255 feet to 15 feet 10 sacks of cement into cellar base. 300 feet of 8-5/8" cemented and left in hole.

APR 16 1948

(If additional description is necessary, use BACK of this sheet)  
Correspondence regarding this well should be addressed to Anschutz & Polcyn  
Address Russell, Kansas

STATE OF Kansas, COUNTY OF Russell, ss. 4-16-48  
..... (employee of owner) or (owner or operator) of the above-described well, being first duly sworn on oath, says: That I have knowledge of the facts, statements, and matters herein contained and the log of the above-described well as filed and that the same are true and correct. So help me God.

(Signature) Frank Polcyn  
Russell, Kans.  
(Address)

SUBSCRIBED AND SWORN TO before me this 14th day of April, 19 48

My commission expires Dec. 1, 1951 Elsie Coody Notary Public.

22-237 T-47-10M  
21 7 26  
40 75