

15-179-20487-00-00


STATE OF KANSAS
STATE CORPORATION COMMISSION

WELL PLUGGING RECORD

Give All Information Completely
Make Required Affidavit
Mail or Deliver Report to
Conservation Division
State Corporation Comm.
245 North Water
Wichita, KS 67202

Sheridan County. Sec. 19 Twp. 7 S Rge. 29 E/W
Location as "NE/CNW $\frac{1}{4}$ SW $\frac{1}{4}$ " or footage from lines
C N/2 SE NW

Lease Owner K & E Petroleum, Inc.
Lease Name Pope "B" Well No. 1
Office Address 816 Union Center, Wichita, Kansas 67202
Character of Well (Completed as Oil, Gas or Dry Hole)
Dry Hole

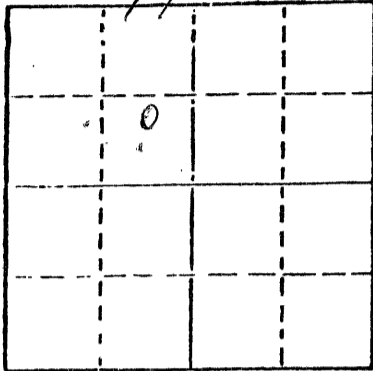

Locate well correctly on above
Section Plat

Date Well completed Nov. 17, 1977
Application for plugging filed (verbally) Nov. 17, 1977
Application for plugging approved (verbally) Nov. 17, 1977
Plugging commenced Nov. 17, 1977
Plugging completed Nov. 17, 1977
Reason for abandonment of well or producing formation
No commercial quantity of oil or gas encountered
If a producing well is abandoned, date of last production 19

Was permission obtained from the Conservation Division or
its agents before plugging was commenced? Yes

Name of Conservation Agent who supervised plugging of this well Gilbert Balthazor
Producing formation _____ Depth to top _____ Bottom _____ Total Depth of Well 4225'
Show depth and thickness of all water, oil and gas formations.

OIL, GAS OR WATER RECORDS

CASING RECORD

FORMATION	CONTENT	FROM	TO	SIZE	PUT IN	PULLED OUT

Describe in detail the manner in which the well was plugged, indicating where the mud fluid
was placed and the method or methods used in introducing it into the hold. If cement or other
plugs were used, state the character of same and depth placed, from _____ feet to
_____ feet for each plug set.

Set 1st plug at 1500' with 70 sacks
2nd plug at 240' with 20 sacks
40' solid bridge with 10 sacks
Cemented with 50/50 posmix, 6% gel
Plug was down at 5:15 p.m., November 17, 1977

(If additional description is necessary, use BACK of this sheet)

Name of Plugging Contractor Abercrombie Drilling, Inc.

STATE OF KANSAS COUNTY OF SEDGWICK, ss.

Jack L. Partridge, Ass't. Sec.-Treas. (employee of owner) or (owner or operator)
of the above-described well, being first duly sworn on oath, says: That I have knowledge of
the facts, statements, and matters herein contained and the log of the above-described well
as filed and that the same are true and correct. So help me God.

(Signature)


Jack L. Partridge

801 Union Center, Wichita, Kansas 67202
(Address)

SUBSCRIBED AND SWORN TO before me this 29th day of November, 1977

Sandra Richman
Sandra Richman Notary Public.

My commission expires July 21, 1979

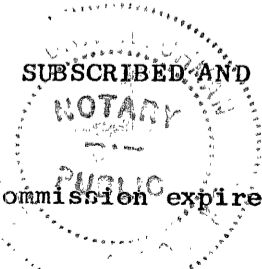

RECEIVED
STATE CORPORATION COMMISSION
11-30-1977
NOV 30 1977

CONSERVATION DIVISION
Wichita, Kansas

OPERATOR: K & E Petroleum, Inc.
 CONTRACTOR: Abercrombie Drilling, Inc.
 WELL NAME: Pope "B" #1
 LOCATION: C N/2 SE NW Section 19-7S-27W
 Sheridan County, Kansas
 SPUD DATE: November 12, 1977
 COMPLETION DATE: November 17, 1977

0	278	Clay & sand
278	286	Blue shale
286	2545	Shale & sand
2545	2588	Anhydrite
2588	3008	Shale & lime
3008	3273	Lime & shale
3273	3475	Shale & lime
3475	3826	Lime & shale
3826	4225	Lime
	4225	Rotary Total Depth

Spud hole at 5:00 p.m., November 12, 1977. Drilled 286' of 12 1/4" hole, ran 7 joints of 8-5/8" surface casing. Set at 285' K.B., cemented with 190 sacks common cement, 3%CaCl, 2%gel. Cement did circulate. Plug was down at 11:00 p.m., November 12, 1977.

T.D. 4225'. Set 1st plug at 1500' with 70 sacks, 2nd plug at 240' with 20 sacks, 40' solid bridge with 10 sacks. Cemented with 50/50 posmix, 6% gel. Plug was down at 5:15 p.m., November 17, 1977

SAMPLE TOPS:


Anhydrite 2546' (+344)
 B/Anhydrite 2588' (+302)

STATE OF KANSAS)
) ss
 COUNTY OF SEDGWICK)

Jack L. Partridge, Assistant Secretary-Treasurer of Abercrombie Drilling, Inc., does hereby state that the above and foregoing is a true and correct copy of the log of the Pope "B" #1, C N/2 SE NW Section 19-7S-27W, Sheridan County, Kansas.

ABERCROMBIE DRILLING, INC.

BY Jack L. Partridge
 Jack L. Partridge,
 Assistant Secretary-Treasurer

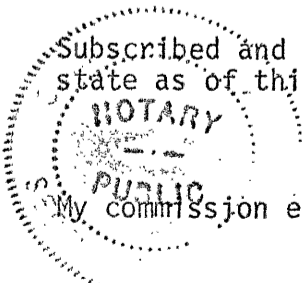

Subscribed and sworn to before me, a Notary Public, in and for the aforesaid county and state as of this 29th day of November, 1977.

My commission expires July 21, 1979.

Sandra Richman
 Sandra Richman, Notary Public

RECEIVED
 STATE CORPORATION COMMISSION

NOV 30 1977

CONSERVATION DIVISION
 Wichita, Kansas