

CARD MUST BE TYPED

State of Kansas

CARD MUST BE SIGNED

NOTICE OF INTENTION TO DRILL

(see rules on reverse side)

Expected Spud Date..... 8/27/87
month day year

API Number 15- 059-24,262-00-00

OPERATOR: License # 9873

NE SW
SE NW NE
Sec. 28 Twp. 15 S, Rg. 20 East West

Name PAINTER OIL COMPANY

Address BOX 141 B, ROUTE 2

City/State/Zip WELLSVILLE, KANSAS 66092

Contact Person JOE SMITH

Phone (913) 242-7310

3795 Ft. from South Line of Section
1815 Ft. from East Line of Section

(Note: Locate well on Section Plat on reverse side)

Nearest lease or unit boundary line 825 feet
County FRANKLIN

CONTRACTOR: License # 3417

Lease Name J. J. SCOTT Well # 6

Name SIMPSON DRILLING

City/State ROUTE 2, BOX 133, OSAWATOMIE, KS 66064

Ground surface elevation feet MSL
Domestic well within 330 feet: yes no

Well Drilled For: Well Class: Type Equipment:

Oil Storage Infield Mud Rotary

Gas Inj Pool Ext. Air Rotary

OWWO Expl Wildcat Cable

Municipal well within one mile: yes no

Depth to bottom of fresh water

Depth to bottom of usable water 200

Surface pipe by Alternate: 1 2

If OWWO: old well info as follows:

Surface pipe planned to be set 40

Conductor pipe required

Projected Total Depth 1000 feet

Formation BARTLESVILLE

Operator

Well Name

Comp Date Old Total Depth

I certify that well will comply with K.S.A. 55-101, et seq., plus eventually plugging hole to KCC specifications.

Date 8/26/87 Signature of Operator or Agent

Greg Engelman

Title AS AGENT

For KCC Use:

Conductor Pipe Required feet; Minimum Surface Pipe Required 20 feet per Alt. 2


This Authorization Expires 2-26-88 Approved By 2-26-87

Must be filed with the K.C.C. five (5) days prior to commencing well
 This card void if drilling not started within six (6) months of date received by K.C.C.

Important procedures to follow:

1. Notify District office before setting surface casing.
2. Set surface casing by circulating cement to the top.
3. File completion forms ACO-1 with K.C.C. within 120 days of well spud date, following instructions on ACO-1, side 1, and including copies of wireline logs.
4. Notify District office 48 hours prior to old well workover or re-entry.
5. Prior to filing Intent, prepare a proposed plugging plan in case well is D & A, then obtain approval of plan when calling district office prior to setting surface pipe.
6. Submit plugging report (CP-4) to K.C.C. after plugging is completed.
7. Obtain an approved injection docket number before disposing of salt water.
8. Notify K.C.C. within 10 days when injection commences or terminates.
9. If an alternate 2 completion, cement in the production pipe from below any usable water to surface within 120 days of spud date.

A Regular Section of Land
 1 Mile = 5,280 Ft.

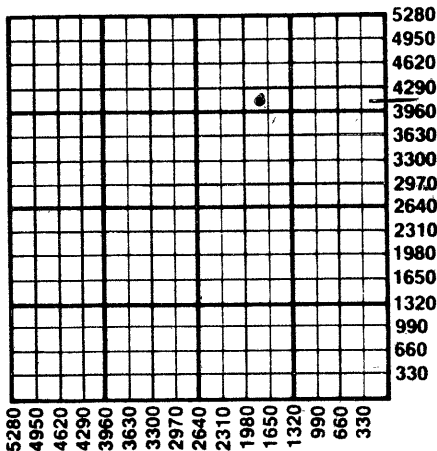

826-87

State Corporation Commission of Kansas
 Conservation Division
 200 Colorado Derby Building
 Wichita, Kansas 67202-1212
 (316) 263-3238

RECEIVED
 STATE CORPORATION COMMISSION
 AUG 26 1987
 CONSERVATION DIVISION
 WICHITA, KANSAS