

CARD MUST BE TYPED

State of Kansas

CARD MUST BE SIGNED

NOTICE OF INTENTION TO DRILL

(see rules on reverse side)

CORRECTION 1-2486

Starting Date 1 24 1986
month day year

API Number 15-059-24,144 00-00

OPERATOR: License # .. 9873
Name .. Painter Oil Company Inc.
Address .. Route 2, Box 141-B
City/State/Zip .. Wellsville, KS 66092
Contact Person..... Jerry Hardsaw
Phone (913) 242-7310

X app C.W/2.E/2.SW Sec. 28.. Twp. 15... S, Rg... 20...
..... 1320.... Ft. from South Line of Section
..... 3443..... Ft. from East Line of Section

(Note: Locate well on Section Plat on reverse side)

CONTRACTOR: License # .. 5666
Name .. Finch's Drilling Inc.
City/State Route 2, Ottawa, KS... 66067

Nearest lease or unit boundary line 803..... feet
County..... Franklin
Lease Name..... Harry Scott Well # WI-6

Well Drilled For: Well Class: Type Equipment:
___ Oil ___ SWD X Infield X Mud Rotary
___ Gas X Inj ___ Pool Ext. ___ Air Rotary
___ OWWO ___ Expl ___ Wildcat ___ Cable

Ground surface elevation feet MSL
Domestic well within 330 feet: ___yes X no
Municipal well within one mile: ___yes X no
Depth to bottom of fresh water: 25
Depth to bottom of usable water 200
Surface pipe by Alternate: 1 ___ 2 X

If OWWO: old well info as follows: wtr. supply X
Operator
Well Name
Comp Date Old Total Depth.....

Surface pipe planned to be set 40
Conductor pipe required
Projected Total Depth 800 feet
Formation..... Squirrel

I certify that well will comply with K.S.A. 55-101, et seq., plus eventually plugging hole to KCC specifications.

Date ... 1/24/86 Signature of Operator or Agent Shane Chalar Title .. as agent

For KCC Use:

Conductor Pipe Required feet; Minimum Surface Pipe Required feet per Alt. 1 2

This Authorization Expires 7-22-86 Approved By 1-22-86
HWAS 28-18-20E


Must be filed with the K.C.C. five (5) days prior to commencing well
 This card void if drilling not started within six (6) months of date received by K.C.C.

Important procedures to follow:

A Regular Section of Land
1 Mile = 5,280 Ft.

RECEIVED
 STATE CORPORATION COMMISSION
 1-24-86
 JAN 24 1986

CONSERVATION DIVISION
 Wichita, Kansas

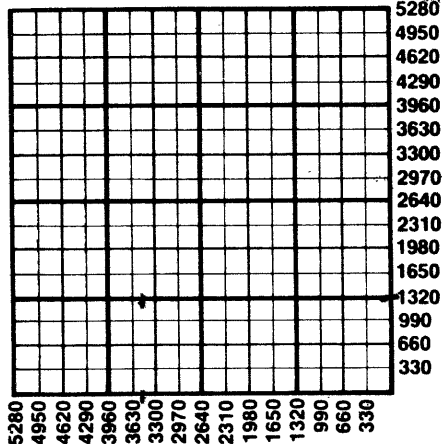

1. Notify District office before setting surface casing.
2. Set surface casing by circulating cement to the top.
3. File completion forms ACO-1 with K.C.C. within 90 days of well completion, following instructions on ACO-1, side 1, and including copies of wireline logs.
4. Notify District office 48 hours prior to old well workover or re-entry.
5. Prior to filing Intent, prepare a proposed plugging plan in case well is D & A, then obtain approval of plan when calling district office prior to setting surface pipe.
6. Submit plugging report (CP-4) to K.C.C. after plugging is completed.
7. Obtain an approved injection docket number before disposing of salt water.
8. Notify K.C.C. within 10 days when injection commences or terminates.
9. If an alternate 2 completion, cement in the production pipe from below any usable water to surface within 120 days of spud date.

State Corporation Commission of Kansas
 Conservation Division
 200 Colorado Derby Building
 Wichita, Kansas 67202
 (316) 263-3238