

CARD MUST BE TYPED

State of Kansas

CARD MUST BE SIGNED

NOTICE OF INTENTION TO DRILL

(see rules on reverse side)

CORRECTION 1-24-86

Starting Date 1 24 1986 month day year

API Number 15-059-24,145-00-00

OPERATOR: License # 9873 Name Painter Oil Company Inc. Address Route 2, Box 141-B City/State/Zip Wellsville, Kansas 66092 Contact Person Jerry Hardsaw Phone (913) 242-7310

X app. SW NE SW Sec. 28 Twp. 15 S, Rg. 20 1650 Ft. from South Line of Section 3443 Ft. from East Line of Section

(Note: Locate well on Section Plat on reverse side)

CONTRACTOR: License # 5666 Name Finch's Drilling Inc. City/State Route 2, Ottawa, KS 66067

Well Drilled For: Oil SWD Infield Inj Gas Inj OWWO Expl Well Class: X Infield Pool Ext Wildcat Type Equipment: X Mud Rotary Air Rotary Cable

If OWWO: old well info as follows: wtr. supply X Operator Well Name Comp Date Old Total Depth

Nearest lease or unit boundary line 803 feet County Franklin Lease Name Harry Scott Well # WI-7 Ground surface elevation feet MSL Domestic well within 330 feet: yes X no Municipal well within one mile: yes X no Depth to bottom of fresh water 25 Depth to bottom of usable water 200 Surface pipe by Alternate: 1 2 X Surface pipe planned to be set 40 Conductor pipe required Projected Total Depth 800 feet Formation Squirrel

I certify that well will comply with K.S.A. 55-101, et seq., plus eventually plugging hole to KCC specifications.

Date 1/24/86 Signature of Operator or Agent Shari Bohler Title as agent

For KCC Use:

Conductor Pipe Required feet; Minimum Surface Pipe Required feet per Alt. 1 2

This Authorization Expires 7-22-86 Approved By 1-22-86

was 28-18-20E


Must be filed with the K.C.C. five (5) days prior to commencing well  
 This card void if drilling not started within six (6) months of date received by K.C.C.

**Important procedures to follow:**

RECEIVED  
 STATE CORPORATION COMMISSION  
 1-24-86

**A Regular Section of Land**  
**1 Mile = 5,280 Ft.**

CONSERVATION DIVISION  
 Wichita, Kansas

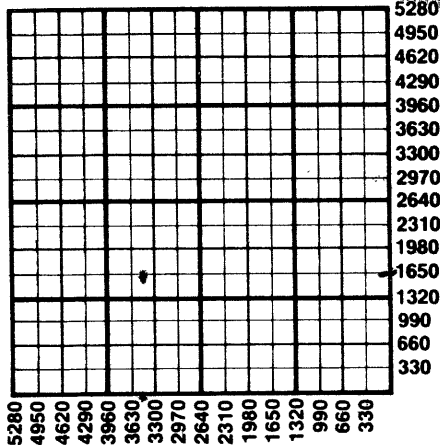

1. Notify District office before setting surface casing.
2. Set surface casing by circulating cement to the top.
3. File completion forms ACO-1 with K.C.C. within 90 days of well completion, following instructions on ACO-1, side 1, and including copies of wireline logs.
4. Notify District office 48 hours prior to old well workover or re-entry.
5. Prior to filing Intent, prepare a proposed plugging plan in case well is D & A, then obtain approval of plan when calling district office prior to setting surface pipe.
6. Submit plugging report (CP-4) to K.C.C. after plugging is completed.
7. Obtain an approved injection docket number before disposing of salt water.
8. Notify K.C.C. within 10 days when injection commences or terminates.
9. If an alternate 2 completion, cement in the production pipe from below any usable water to surface within 120 days of spud date.

State Corporation Commission of Kansas  
 Conservation Division  
 200 Colorado Derby Building  
 Wichita, Kansas 67202  
 (316) 263-3238