

CARD MUST BE TYPED

State of Kansas

CARD MUST BE SIGNED

NOTICE OF INTENTION TO DRILL

(see rules on reverse side)

Starting Date 01/03/87 month day year

API Number 15- 059-24197-00-00

OPERATOR: License # 9873
Name Painter Oil Company
Address Box 141 B, Route 2
City/State/Zip Wellsville, Kansas 66092
Contact Person Joe Smith
Phone (913) 242-7310

app. C. SW. SE Sec. 28 Twp. 15 S, Rg. 20. East West
660 Ft. from South Line of Section
2123 Ft. from East Line of Section

(Note: Locate well on Section Plat on reverse side)

CONTRACTOR: License # 6807
Name Oil Drillers & Developers, Inc
City/State Topeka, Kansas

Nearest lease or unit boundary line 660 feet
County Franklin
Lease Name Harry Scott Well # 9

Well Drilled For: Well Class: Type Equipment:
___ Oil ___ SWD Infield ___ Mud Rotary
___ Gas ___ Inj ___ Pool Ext. ___ Air Rotary
___ OWWO ___ Expl ___ Wildcat ___ Cable

Ground surface elevation na feet MSL
Domestic well within 330 feet: ___ yes no
Municipal well within one mile: ___ yes no
Depth to bottom of fresh water 60
Depth to bottom of usable water 200
Surface pipe by Alternate: 1 ___ 2
Surface pipe planned to be set 40
Conductor pipe required na
Projected Total Depth 800 feet
Formation Squirrel

If OWWO: old well info as follows:

Operator
Well Name
Comp Date Old Total Depth

I certify that well will comply with K.S.A. 55-101, et seq., plus eventually plugging hole to KCC specifications.

Date 12/31/86 Signature of Operator or Agent Susan Arnold Title As. Agent

For KCC Use:

Conductor Pipe Required 7 feet; Minimum Surface Pipe Required 20 feet per Alt. 2
This Authorization Expires 7-1-87 Approved By 12-31-86


[Handwritten signature]

Must be filed with the K.C.C. five (5) days prior to commencing well
 This card void if drilling not started within six (6) months of date received by K.C.C.

Important procedures to follow:

1. Notify District office before setting surface casing.
2. Set surface casing by circulating cement to the top.
3. File completion forms ACO-1 with K.C.C. within 90 days of well completion, following instructions on ACO-1, side 1, and including copies of wireline logs.
4. Notify District office 48 hours prior to old well workover or re-entry.
5. Prior to filing Intent, prepare a proposed plugging plan in case well is D & A, then obtain approval of plan when calling district office prior to setting surface pipe.
6. Submit plugging report (CP-4) to K.C.C. after plugging is completed.
7. Obtain an approved injection docket number before disposing of salt water.
8. Notify K.C.C. within 10 days when injection commences or terminates.
9. If an alternate 2 completion, cement in the production pipe from below any usable water to surface within 120 days of spud date.

**A Regular Section of Land
 1 Mile = 5,280 Ft.**

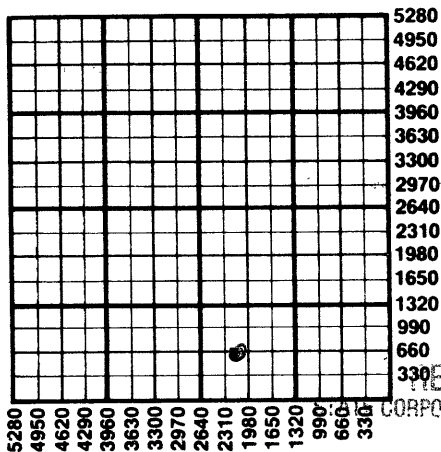

RECEIVED
 CORPORATION COMMISSION

DEC 31 1986
 12-31-86
 CONSERVATION DIVISION
 Wichita, Kansas

State Corporation Commission of Kansas
 Conservation Division
 200 Colorado Derby Building
 Wichita, Kansas 67202
 (316) 263-3238