

CARD MUST BE TYPED

State of Kansas
NOTICE OF INTENTION TO DRILL

CARD MUST BE SIGNED

(see rules on reverse side)

Starting Date:7.....16.....85.....
month day year

API Number 15- 059-23991-00-00

OPERATOR: License # 9873.....

..SW. NE. NE. Sec .29. Twp 15. S, Rge .20. East
(location) West

NamePainter Oil Company Inc.....

Address9865 Fairwood Lane.....

City/State/ZipMemphis, Tennessee 38119.....

Contact PersonJerry Hardsaw.....

Phone913 242-5332.....

.....4.125... Ft North from Southeast Corner of Section
.....825.... Ft West from Southeast Corner of Section
(Note: Locate well on Section Plat on reverse side)

CONTRACTOR: License # 5666.....

NameFinchas Drilling.....

City/StateOttawa, KS.....62667.....

Nearest lease or unit boundary line ...825..... feet.
CountyFranklin.....

Lease NameAllen Vick..... Well#9.....

Domestic well within 330 feet : yes no

Municipal well within one mile : yes no

Well Drilled For:

Well Class:

Type Equipment:

Oil Swd

Anfield

Mud Rotary

Gas Inj

Pool Ext.

Air Rotary

OWWO Expl

Wildcat

Cable

If OWWO: old well info as follows:

Operator

Well Name

Comp Date Old Total Depth

Projected Total Depth800..... feet

Projected Formation at TDSquirrel.....

Expected Producing Formations

Depth to Bottom of fresh waternone - 100..... feet

Lowest usable water formation Douglas Group.....

Depth to Bottom of usable water200..... feet

Surface pipe by Alternate : 1 2

Surface pipe to be set40..... feet

Conductor pipe if any required feet

Ground surface elevation feet MSL

This Authorization Expires1-16-86.....

Approved By7-16-85.....

I certify that we will comply with K.S.A. 55-101, et seq., plus eventually plugging hole to K.C.C. specifications.

[Signature]
PCA for KOHE

Date ..7/16/85... Signature of Operator or Agent

[Signature]

TitleAs agent.....

Must be filed with the K.C.C. five (5) days prior to commencing well
 This card void if drilling not started within six (6) months of date received by K.C.C.

58-91-21


RECEIVED
 STATE CORPORATION COMMISSION

JUL 16 1985

CONSERVATION DIVISION
 Wichita, Kansas

Important procedures to follow:

A Regular Section of Land
 1 Mile = 5,280 Ft.

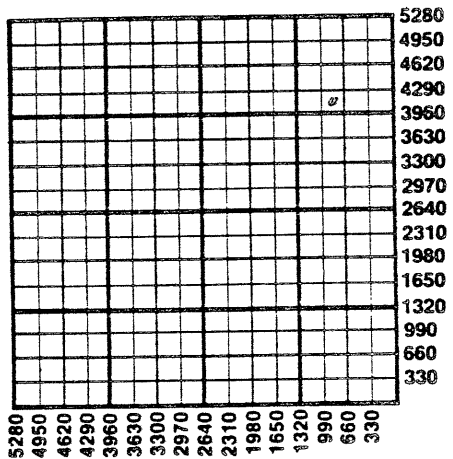

1. Notify District office before setting surface casing.
2. Set surface casing by circulating cement to the top.
3. File completion forms ACO-1 with K.C.C. within 90 days of well completion, following instructions on ACO-1, side 1, and including copies of wireline logs.
4. Notify District office 48 hours prior to old well workover or re-entry.
5. Prior to plugging, prepare a plugging plan, then obtain agreement from the appropriate district office for an approved plugging plan.
6. Submit plugging report (CP-4) to K.C.C. after plugging is completed.
7. Obtain an approved injection docket number before disposing of salt water.
8. Notify K.C.C. within 10 days when injection commences or terminates.
9. If an alternate 2 completion, cement in the production pipe from below any usable water to surface within 120 days of spud date.

State Corporation Commission of Kansas
 Conservation Division
 200 Colorado Derby Building
 Wichita, Kansas 67202
 (316) 263-3238