

CARD MUST BE TYPED

State of Kansas  
NOTICE OF INTENTION TO DRILL

(see rules on reverse side)

CARD MUST BE SIGNED

Starting Date: ..... 7 ..... 16 ..... 85 .....  
month day year

API Number 15- 059-23,992-00-00

OPERATOR: License # 9873  
Name Painter Oil Company Inc  
Address 9865 Fairwood Lane  
City/State/Zip Memphis, Tennessee 38119  
Contact Person Jerry Hardsaw  
Phone 913 242-5332

SW NE NE Sec 29 15 20 XX East  
(location) S, Rge 20 West

4455  
825 Ft North from Southeast Corner of Section  
825 Ft West from Southeast Corner of Section  
(Note: Locate well on Section Plat on reverse side)

CONTRACTOR: License # 5666  
Name Finches Drilling  
City/State Ottawa KS 66067

Nearest lease or unit boundary line Franklin feet.

County Allen Vick 10

Lease Name Well#

Domestic well within 330 feet:  yes  no

Municipal well within one mile:  yes  no

Well Drilled For: Well Class: Type Equipment:  
XX Oil  Swd XX Infield  Mud Rotary  
 Gas  Inj  Pool Ext.  Air Rotary  
 OWWO  Expl  Wildcat  Cable

Depth to Bottom of fresh water none ~100 feet

Lowest usable water formation Douglas Group 200 feet

Depth to Bottom of usable water 200 feet

Surface pipe by Alternate: 1  40

Surface pipe to be set feet

Conductor pipe if any required feet

Ground surface elevation feet MSL

This Authorization Expires 1-16-86

Approved By 7-16-85 RCH SOKOLHE

If OWWO: old well info as follows:  
Operator  
Well Name  
Comp Date Old Total Depth  
Projected Total Depth 800 feet  
Projected Formation at TD Squirrel  
Expected Producing Formations

I certify that we will comply with K.S.A. 55-101, et seq., plus eventually plugging hole to K.C.C. specifications.

Date 7/16/85 Signature of Operator or Agent Susan Arnold

Title As agent

This card void if drilling not started within six (6) months of date received by K.C.C.

SS-91-L


Important procedures to follow:

RECEIVED  
STATE CORPORATION COMMISSION

JUL 16 1985

CONSERVATION DIVISION  
Wichita, Kansas

**A Regular Section of Land  
1 Mile = 5,280 Ft.**

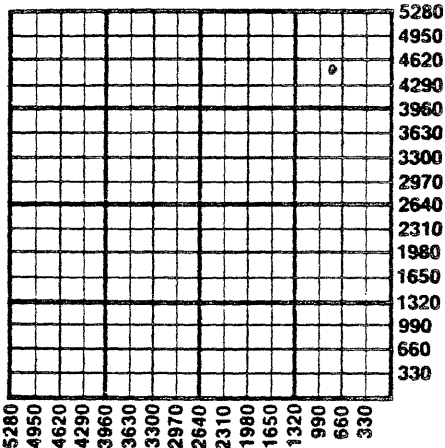

1. Notify District office before setting surface casing.
2. Set surface casing by circulating cement to the top.
3. File completion forms ACO-1 with K.C.C. within 90 days of well completion, following instructions on ACO-1, side 1, and including copies of wireline logs.
4. Notify District office 48 hours prior to old well workover or re-entry.
5. Prior to plugging, prepare a plugging plan, then obtain agreement from the appropriate district office for an approved plugging plan.
6. Submit plugging report (CP-4) to K.C.C. after plugging is completed.
7. Obtain an approved injection docket number before disposing of salt water.
8. Notify K.C.C. within 10 days when injection commences or terminates.
9. If an alternate 2 completion, cement in the production pipe from below any usable water to surface within 120 days of spud date.

State Corporation Commission of Kansas  
Conservation Division  
200 Colorado Derby Building  
Wichita, Kansas 67202  
(316) 263-3238