

CARD MUST BE TYPED

# NOTICE OF INTENTION TO DRILL

(see rules on reverse side)

CARD MUST BE SIGNED

Starting Date: ..... 7 ..... 16 ..... 85 .....  
month day year

API Number 15- 059-23, 990-00-00

OPERATOR: License # 9873  
Name Painter Oil Company Inc.  
Address 9865 Fairwood Lane  
City/State/Zip Memphis, Tennessee 38119  
Contact Person Jerry Hardsaw  
Phone 913 242-5332

NE SW NE Sec 29 Twp 15 S Rge 20  East  
(location)  West

3795 Ft North from Southeast Corner of Section  
1815 Ft West from Southeast Corner of Section  
(Note: Locate well on Section Plat on reverse side)

CONTRACTOR: License # 5666  
Name Finches D.B.G.  
City/State Ottawa KS 66067

Nearest lease or unit boundary line 1155 feet.  
County Franklin  
Lease Name Allen Vick Well# 8

Well Drilled For: Well Class: Type Equipment:  
 Oil  Swd  Infield  Mud Rotary  
 Gas  Inj  Pool Ext.  Air Rotary  
 OWWO  Expl  Wildcat  Cable

Domestic well within 330 feet:  yes  no  
Municipal well within one mile:  yes  no

If OWWO: old well info as follows:

Operator .....  
Well Name .....  
Comp Date ..... Old Total Depth .....  
Projected Total Depth 800 feet  
Projected Formation at TD Squirrel  
Expected Producing Formations .....

Depth to Bottom of fresh water none ~ 100 feet  
Lowest usable water formation Douglas Group  
Depth to Bottom of usable water 200 feet  
Surface pipe by Alternate: 1  2   
Surface pipe to be set 40 feet  
Conductor pipe if any required ..... feet  
Ground surface elevation ..... feet MSL  
This Authorization Expires 1-16-86  
Approved By 7-6-85 R.C. [Signature]

I certify that we will comply with K.S.A. 55-101, et seq., plus eventually plugging hole to K.C.C. specifications.

Date 7/16/85 Signature of Operator or Agent Susan Arnold Title As agent

RCR for KDAE

Must be filed with the K.C.C. five (5) days prior to commencing well  
 This card void if drilling not started within six (6) months of date received by K.C.C.


RECEIVED  
 STATE CORPORATION COMMISSION

JUL 16 1985

58-91-L

Important procedures to follow  
 CONSERVATION DIVISION  
 Wichita, Kansas

**A Regular Section of Land**  
 1 Mile = 5,280 Ft.

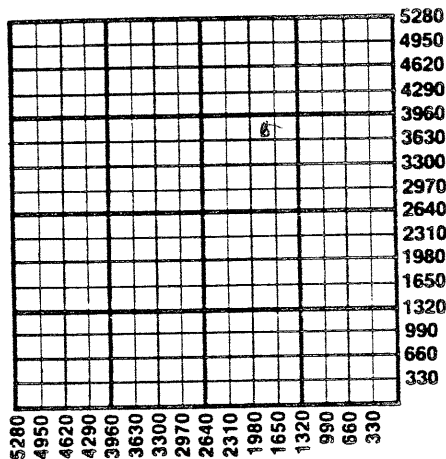

1. Notify District office before setting surface casing.
2. Set surface casing by circulating cement to the top.
3. File completion forms ACO-1 with K.C.C. within 90 days of well completion, following instructions on ACO-1, side 1, and including copies of wireline logs.
4. Notify District office 48 hours prior to old well workover or re-entry.
5. Prior to plugging, prepare a plugging plan, then obtain agreement from the appropriate district office for an approved plugging plan.
6. Submit plugging report (CP-4) to K.C.C. after plugging is completed.
7. Obtain an approved injection docket number before disposing of salt water.
8. Notify K.C.C. within 10 days when injection commences or terminates.
9. If an alternate 2 completion, cement in the production pipe from below any usable water to surface within 120 days of spud date.

State Corporation Commission of Kansas  
 Conservation Division  
 200 Colorado Derby Building  
 Wichita, Kansas 67202  
 (316)263-3238