

CARD MUST BE TYPED

State of Kansas

CARD MUST BE SIGNED

NOTICE OF INTENTION TO DRILL

(see rules on reverse side)

Starting Date 12 month 31 day 1985 year

API Number 15— 059-24,126-00-00

OPERATOR: License # 9873 app. SE. NW. NE.
Name Painter Oil Company Inc.
Address Rt. 2, Box 141-B
City/State/Zip Wellsville, Kansas 66092
Contact Person Jerry Hardsaw
Phone 913.242-7310

..... East
..... West
Sec. 29... Twp. 15. S, Rg. 20...
..... 4455 Ft. from South Line of Section
..... 1815 Ft. from East Line of Section

(Note: Locate well on Section Plat on reverse side)

CONTRACTOR: License # 5666
Name Finch's Drilling Inc.
City/State Rt. 2, Ottawa, Kansas 66067

Nearest lease or unit boundary line 825 feet

County Franklin

Lease Name Allen Vick Well # 21

Ground surface elevation n/a feet MSL

Well Drilled For: Well Class: Type Equipment:
 Oil SWD Infield Mud Rotary
 Gas Inj Pool Ext. Air Rotary
 OWWO Expl Wildcat Cable

Domestic well within 330 feet: yes no

Municipal well within one mile: yes no

Surface pipe by Alternate: 1 2

If OWWO: old well info as follows:
Operator
Well Name
Comp Date Old Total Depth

Depth to bottom of fresh water 60

Depth to bottom of usable water 200

Surface pipe planned to be set 40

Projected Total Depth 790 feet

Formation

I certify that well will comply with K.S.A. 55-101, et seq., plus eventually plugging hole to KCC specifications.

..... cementing will be done immediately upon setting production casing.

Date 12/31/85 Signature of Operator or Agent Title as agent

For KCC Use:

Conductor Pipe Required feet; Minimum Surface Pipe Required 40 feet per Alt. 1

This Authorization Expires 7-1-86 Approved By BK

Post/KCC

Must be filed with the K.C.C. five (5) days prior to commencing well
 This card void if drilling not started within six (6) months of date received by K.C.C.

Important procedures to follow:


RECEIVED
 STATE CORPORATION COMMISSION

Notify District office before setting surface casing.

A Regular Section of Land

1 Mile = 5,280 Ft.

DEC 31 1985
 CONSERVATION DIVISION
 Wichita, Kansas
 12-31-85

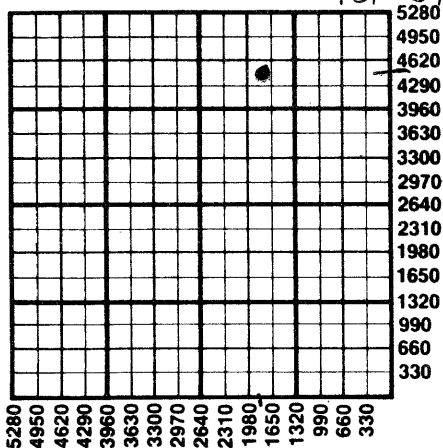

2. Set surface casing by circulating cement to the top.
3. File completion forms ACO-1 with K.C.C. within 90 days of well completion, following instructions on ACO-1, side 1, and including copies of wireline logs.
4. Notify District office 48 hours prior to old well workover or re-entry.
5. Prior to filing Intent, prepare a proposed plugging plan in case well is D & A, then obtain approval of plan when calling district office prior to setting surface pipe.
6. Submit plugging report (CP-4) to K. C. C. after plugging is completed.
7. Obtain an approved injection docket number before disposing of salt water.
8. Notify K.C.C. within 10 days when injection commences or terminates.
9. If an alternate 2 completion, cement in the production pipe from below any usable water to surface within 120 days of spud date.

State Corporation Commission of Kansas
 Conservation Division
 200 Colorado Derby Building
 Wichita, Kansas 67202
 (316) 263-3238