

CARD MUST BE TYPED

State of Kansas

CARD MUST BE SIGNED

NOTICE OF INTENTION TO DRILL

(see rules on reverse side)

Starting Date .. December 7, 1985 .. month day year

API Number 15- 059-24/114-00-00

OPERATOR: License # 7069
Name Arlo S. Hermreck Oil Co.
Address 511 Terrace Trail East
City/State/Zip Lake Quivira, K.C. Ks. 66106
Contact Person Arlo S. Hermreck
Phone 913-268-9152

S/2 NE/4 Sec 29 Twp 15 S, Rg 20
3795 Ft. from South Line of Section
495 Ft. from East Line of Section

(Note: Locate well on Section Plat on reverse side)

CONTRACTOR: License # 6807
Name Oil Drillers & Developers
City/State 7939 S.W. 29th Topeka, Ks. 66614

Nearest lease or unit boundary line .. 165 feet
County Franklin
Lease Name Hermreck Lease Well # 2
Ground surface elevation .. feet MSI
Domestic well within 330 feet: yes no
Municipal well within one mile: yes no
Surface pipe by Alternate: 1 2 X
Depth to bottom of fresh water .. 20-30 feet
Depth to bottom of usable water .. 200 feet
Surface pipe planned to be set .. 50-80 feet
Projected Total Depth .. 800 feet
Formation Squirrel #1 & #2

Well Drilled For: Well Class: Type Equipment:
X Oil SWD X Infield X Mud Rotary
Gas Inj Pool Ext Air Rotary
OWWO Expl Wildcat Cable

If OWWO: old well info as follows:
Operator
Well Name
Comp Date Old Total Depth

I certify that well will comply with K.S.A. 55-101, et seq., plus eventually plugging hole to KCC specifications.

cementing will be done immediately upon setting production casing.

Date 11-26-85 Signature of Operator or Agent Title and Owner

feet/kote

For KCC Use:

Conductor Pipe Required .. feet; Minimum Surface Pipe Required .. feet per Alt. 2


This Authorization Expires 5-9-86 Approved By 12-9-85

Must be filed with the K.C.C. five (5) days prior to commencing well
This card void if drilling not started within six (6) months of date received by K.C.C.

Important procedures to follow:

1. Notify District office before setting surface casing.
2. Set surface casing by circulating cement to the top.
3. File completion forms ACO-1 with K.C.C. within 90 days of well completion, following instructions on ACO-1, side 1, and including copies of wireline logs.
4. Notify District office 48 hours prior to old well workover or re-entry.
5. Prior to filing Intent, prepare a proposed plugging plan in case well is D & A, then obtain approval of plan when calling district office prior to setting surface pipe.
6. Submit plugging report (CP-4) to K. C. C. after plugging is completed.
7. Obtain an approved injection docket number before disposing of salt water.
8. Notify K.C.C. within 10 days when injection commences or terminates.

A Regular Section of Land
1 Mile = 5,280 Ft.

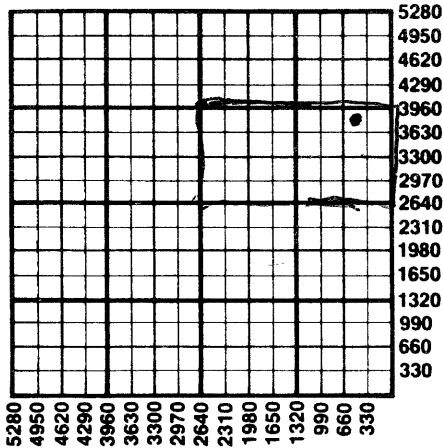

9. If an alternate 2 completion, cement in the production pipe from below any usable water to surface within 120 days of spud date.

STATE CORPORATION COMMISSION

STATE CORPORATION COMMISSION

DEC 2 1985
12-2-85
CONSERVATION DIVISION
Wichita, Kansas

State Corporation Commission of Kansas
Conservation Division
200 Colorado Derby Building
Wichita, Kansas 67202
(316) 263-3238

DEC 9 1985

CONSERVATION DIVISION
Wichita, Kansas