

CARD MUST BE TYPED

State of Kansas

CARD MUST BE SIGNED

### NOTICE OF INTENTION TO DRILL

(see rules on reverse side)

Starting Date December 1, 1985  
month day year

API Number 15- 059-24, 115-00-00  
S/2 NE/4 Sec. 29 Twp. 15 S, Rg. 20  East  
3350 3795 Ft. from South Line of Section  
825 Ft. from East Line of Section

OPERATOR: License # 7069  
Name Arlo S. Hermreck Oil Co.  
Address 511 Terrace Trail East  
City/State/Zip Lake Quivira, K.C. Ks. 66106  
Contact Person Arlo S. Hermreck  
Phone 913-268-9152

(Note: Locate well on Section Plat on reverse side)

CONTRACTOR: License # 6807  
Name Oil Drillers & Developers Inc.  
City/State 7939 S.W. 29th Topeka, Ks. 66614

Nearest lease or unit boundary line 165 feet  
County Franklin  
Lease Name Hermreck Lease Well # 3  
Ground surface elevation 800 feet MSL  
Domestic well within 330 feet:  yes  no  
Municipal well within one mile:  yes  no  
Surface pipe by Alternate: 1 2   
Depth to bottom of fresh water 20-30 feet  
Depth to bottom of usable water 200 feet  
Surface pipe planned to be set 50-80 feet  
Projected Total Depth 800 feet  
Formation Squirrel #. 1 & #. 2

Well Drilled For: Well Class: Type Equipment:  
 Oil  SWD  Infield  Mud Rotary  
 Gas  Inj  Pool Ext.  Air Rotary  
 OWWO  Expl  Wildcat  Cable

If OWWO: old well info as follows:

Operator .....  
Well Name .....  
Comp Date ..... Old Total Depth .....

I certify that well will comply with K.S.A. 55-101, et seq., plus eventually plugging hole to KCC specifications.

                     cementing will be done immediately upon setting production casing.

Date 11-20-85 Signature of Operator or Agent Arlo S. Hermreck Title Land Owner

*pet/KSH*

For KCC Use:

Conductor Pipe Required ..... feet; Minimum Surface Pipe Required ..... feet per Alt. 1 2


This Authorization Expires 6-9-86 Approved By 12-9-85

Must be filed with the K.C.C. five (5) days prior to commencing well  
 This card void if drilling not started within six (6) months of date received by K.C.C.

**Important procedures to follow:**

1. Notify District office before setting surface casing.
2. Set surface casing by circulating cement to the top.
3. File completion forms ACO-1 with K.C.C. within 90 days of well completion, following instructions on ACO-1, side 1, and including copies of wireline logs.
4. Notify District office 48 hours prior to old well workover or re-entry.
5. Prior to filing Intent, prepare a proposed plugging plan in case well is D & A, then obtain approval of plan when calling district office prior to setting surface pipe.
6. Submit plugging report (CP-4) to K.C.C. after plugging is completed.
7. Obtain an approved injection docket number before disposing of salt water.
8. Notify K.C.C. within 10 days when injection commences or terminates.
9. If an alternate 2 completion, cement in the production pipe from below any usable water to surface within 120 days of spud date.

**A Regular Section of Land**  
**1 Mile = 5,280 Ft.**

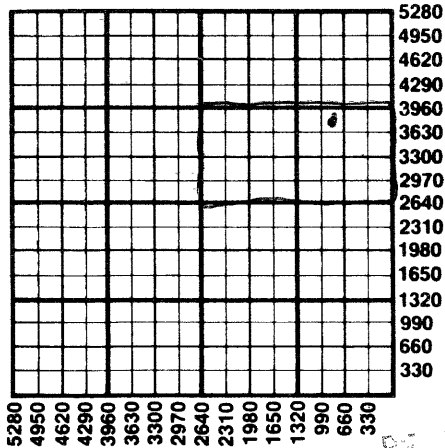

STATE CORPORATION COMMISSION

REC-12  
 DEC 2 1985

CONSERVATION DIVISION  
 WICHITA, KANSAS

State Corporation Commission of Kansas

Conservation Division  
 200 Colorado Derby Building  
 Wichita, Kansas 67202  
 (316) 263-3238

REC-12  
 DEC 9 1985

CONSERVATION DIVISION