

STATE OF KANSAS  
STATE CORPORATION COMMISSION


Give All Information Completely  
Make Required Affidavit  
Mail or Deliver Report to:  
Conservation Division  
State Corporation Commission  
212 No. Market  
Wichita, Kansas

15-181-20003-00-00

Form CP-4

WELL PLUGGING RECORD

NORTH

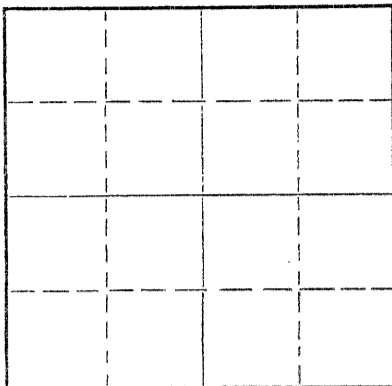

Locate well correctly on above  
Section Plat

Sherman County, Sec. 18 Twp. 7S Rge. 41W ~~(E)~~ (W) West

Location as "NE/CNW/SW" or footage from lines C NW SW

Lease Owner Mack Oil Co.

Lease Name Bair Well No. 1

Office Address 812 Union Center Bldg., Wichita, Kansas 67202

Character of Well (completed as Oil, Gas or Dry Hole) Dry Hole

Date well completed January 11 19 69

Application for plugging filed January 11 19 69

Application for plugging approved January 11 19 69

Plugging commenced January 12 19 69

Plugging completed January 12 19 69

Reason for abandonment of well or producing formation Dry

If a producing well is abandoned, date of last production \_\_\_\_\_ 19 \_\_\_\_\_

Was permission obtained from the Conservation Division or its agents before plugging was commenced? Yes

Name of Conservation Agent who supervised plugging of this well W. L. Nichols

Producing formation None Depth to top \_\_\_\_\_ Bottom \_\_\_\_\_ Total Depth of Well 5476 Feet

Show depth and thickness of all water, oil and gas formations.

OIL, GAS OR WATER RECORDS

CASING RECORD

FORMATION	CONTENT	FROM	TO	SIZE	PUT IN	PULLED OUT

Describe in detail the manner in which the well was plugged, indicating where the mud fluid was placed and the method or methods used in introducing it into the hole. If cement or other plugs were used, state the character of same and depth placed, from \_\_\_\_\_ feet to \_\_\_\_\_ feet for each plug set.

Plugged with 120 sacks cement @ 2725'  
25 sacks cement @ 425'  
10 sacks cement @ 40' to surface  
Plug down @ 3:00 p.m., January 12, 1969

RECEIVED  
STATE CORPORATION COMMISSION  
JAN 16 1969  
CONSERVATION DIVISION  
Wichita, Kansas

1/16/69

(If additional description is necessary, use BACK of this sheet)

Name of Plugging Contractor MACK OIL CO.  
Address P. O. Box 400, Duncan, Oklahoma 73533

STATE OF KANSAS, COUNTY OF SEDGWICK, ss.  
Robert L. Harris (employee of owner) or (owner or operator) of the above-described

well, being first duly sworn on oath, says: That I have knowledge of the facts, statements, and matters herein contained and the log of the above-described well as filed and that the same are true and correct. So help me God.

(Signature) Robert L. Harris

812 Union Center Building, Wichita, Kansas  
(Address)

SUBSCRIBED AND SWORN TO before me this 14th day of January, 19 69



Elizabeth F. Nice  
Notary Public.

September 21, 1972

15-181-20003-00-00

MACK OIL CO.  
Duncan, Oklahoma  
73533

DRILLERS WELL LOG

#1 Bair

Commenced R. D.: 12-18-68  
Completed R. D.: 1-11-69  
Drillers Total Depth: 5470'

C NW SW - Section 18-7S-41W  
Sherman County, Kansas  
Elevation: 3862' Kelly Bushing  
Initial Production: Dry  
Contractor: Mack Oil Co.

STRATA	DEPTH
Surface Soil & Shale	0 - 385'
Shale	385 - 1190
Shale & Lime	1190 - 1918
Shale	1918 - 2607
Sand, Shale & Lime	2607 - 2891
Shale & Lime	2891 - 3272
Shale, Lime with Anhydrite Gyp.	3272 - 3372
Shale, Lime with Anhydrite Strks	3372 - 3562
Shale & Anhydrite	3562 - 3680
Shale & Lime	3680 - 4000
Lime & Shale	4000 - 4435
Lime	4435 - 5266
Lime & Sand	5266 - 5470' - R.T.D.

I hereby certify that the above is a true and correct log of said well as reflected by the daily drilling reports.

MACK OIL CO.

RECEIVED  
STATE CORPORATION COMMISSION  
JAN 16 1969 1/16/69  
CONSERVATION DIVISION  
Wichita, Kansas

By Robert L. Harris  
Robert L. Harris

Signed and sworn to in my presence this 15th day of January, 1969, by Robert L. Harris, representative of Mack Oil Co.

Elizabeth F. Nice  
Elizabeth F. Nice, Notary Public



Notary Public Commission expires  
September 31, 1972