

STATE OF KANSAS
STATE CORPORATION COMMISSION

WELL PLUGGING RECORD

Give All Information Completely
Make Required Affidavit
Mail or Deliver Report to
Conservation Division
State Corporation Comm.
245 North Water
Wichita, KS 67202

Sherman County, Sec. 14 Twp. 7S Rge. 41 ~~E~~W
Location as "NE/CNW $\frac{1}{4}$ SW $\frac{1}{4}$ " or footage from lines _____

SE SE NW


Lease Owner Abraxas Petroleum Corporation
Lease Name White Well No. #1
Office Address 330 - 1100 N.E. Loop 410, San Antonio, Tex. 78217
Character of Well (Completed as Oil, Gas or Dry Hole) _____
Dry Hole

Date Well completed 10-17-79 19
Application for plugging filed 10-16-79 19
Application for plugging approved 10-16-79 19
Plugging commenced 10-16-79 19
Plugging completed 10-17-79 19

Reason for abandonment of well or producing formation _____
Commercial quantities of oil not found
If a producing well is abandoned, date of last production _____ 19

Was permission obtained from the Conservation Division or its agents before plugging was commenced? Yes

Name of Conservation Agent who supervised plugging of this well Gil Balthazor, Palco, Kansas
Producing formation _____ Depth to top _____ Bottom _____ Total Depth of Well 5310'
Show depth and thickness of all water, oil and gas formations.

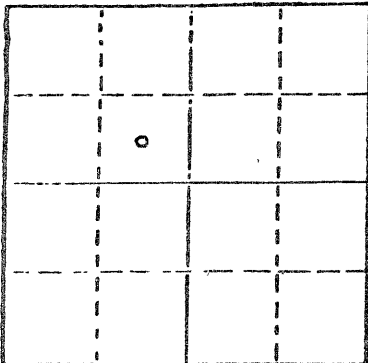

Locate well correctly on above Section Plat

OIL, GAS OR WATER RECORDS

CASING RECORD

FORMATION	CONTENT	FROM	TO	SIZE	PUT IN	PULLED OUT
				8 5/8"	372'	None

Describe in detail the manner in which the well was plugged, indicating where the mud fluid was placed and the method or methods used in introducing it into the hold. If cement or other plugs were used, state the character of same and depth placed, from _____ feet to _____ feet for each plug set.

Plug @ 2000' w/60 sx.
Plug @ 360' w/30 sx.
Plug @ 40' w/10 sx.
Rat Hole 5 sx.

RECEIVED
STATE CORPORATION COMMISSION

OCT 29 1979 10/29/79

CONSERVATION DIVISION
Wichita, Kansas

(If additional description is necessary, use BACK of this sheet)

Name of Plugging Contractor Rains & Williamson Oil Co., Inc.

STATE OF Kansas COUNTY OF Sedgwick, ss.
Wilson Rains, President of Rains & Williamson Oil Co., Inc. (employee of owner) or (owner or operator) of the above-described well, being first duly sworn on oath, says: That I have knowledge of the facts, statements, and matters herein contained and the log of the above-described well as filed and that the same are true and correct. So help me God.

(Signature) Wilson Rains
435 Page Court, 220 W. Douglas, Wichita, Kansas 67202
(Address)

SUBSCRIBED AND SWORN TO before me this 23 day of October, 1979



Juanita M. Green
Juanita M. Green Notary Public.

10-4-83

15-181-20071-00-00

STATE OF KANSAS
STATE CORPORATION COMMISSION - CONSERVATION DIVISION
245 North Water
Wichita, Kansas 67202

FORM C-2

DATA AND AFFIDAVIT

(On Cementing in Surface or Drive Pipe and required by Rule 82-2-123 of the Commission for compliance with Section 55-136, 55-137 and 55-138, 1947 Supplement to G. S. Kansas 1935)

LEASE OWNER Abraxas Petroleum Corporation

OFFICE ADDRESS 330 - 1100 N.E. Loop 410, San Antonio, Texas 78217

LEASE NAME White WELL NO. #1 COUNTY Sherman

EXACT SPOT LOCATION SE SE NW SEC. 14 TWP. 7S RGE. 41 (W) (S)

CONTRACTOR Rains & Williamson Oil Co., Inc.

OFFICE ADDRESS 435 Page Court, 220 W. Douglas, Wichita, Kansas 67202

Drilled with (~~Cable~~) or (Rotary) tools: Date pipe set 9-26-79

SURFACE HOLE DATA

SURFACE PIPE DATA

Size of Hole 12 1/4" Csg. (new) or (~~used~~) Size 8 5/8" Wt. 20#

Depth 380' Where set 372'

METHOD OF CEMENTING

Cement: Amount and kind 250 sx. 50/50 poz., 2% gel, 3% cc.

Method: (By Service Co., Dump, Tog., etc.) Service Co.

Est. Height Cement behind pipe Cement circulated

GROUND WATER INFORMATION

Depth to bottom of lowest fresh water producing stratum 10/29/79

Name of lowest fresh water producing stratum _____

Surface elevation of well _____

ADDITIONAL INFORMATION

(Additional information may be submitted on separate sheet)

A F F I D A V I T

STATE OF Kansas, COUNTY OF Sedgwick SS,

I, Wilson Rains, President, of the Rains & Williamson Oil Company, Inc. being first duly sworn on oath, state: That I have knowledge of the facts, statements and matters herein contained and that the same are true and correct.

Wilson Rains
Wilson Rains

Subscribed and sworn to before me on this 23 day of October 19 79

My Commission Expires: _____

Juanita M. Green
Notary Public Juanita M. Green

