

15-163-20040-00-00

STATE OF KANSAS  
STATE CORPORATION COMMISSION

Form CP-4

WELL PLUGGING RECORD

Give All Information Completely  
Make Required Affidavit  
Mail or Deliver Report to:  
Conservation Division  
State Corporation Commission  
212 No. Market  
Wichita, Kansas

Rooks County. Sec. 29 Twp. 8S Rge. (E) 16 (W)

Location as "NE/CNW/SE/SW" or footage from lines SE SE SW

Lease Owner Rains & Williamson Oil Co., Inc.

Lease Name GAGER Well No. 1

Office Address 1425 Wichita Plaza Bldg. - Wichita, Kansas

Character of Well (completed as Oil, Gas or Dry Hole) Dry Hole

Date well completed 8-2 19 67

Application for plugging filed 8-1 19 67

Application for plugging approved 8-1 19 67


Plugging commenced 8-1 19 67

Plugging completed 12:30 AM, 8-2 19 67

Reason for abandonment of well or producing formation No oil or gas found in commercial quantities

If a producing well is abandoned, date of last production -- 19 --

Was permission obtained from the Conservation Division or its agents before plugging was commenced? Yes

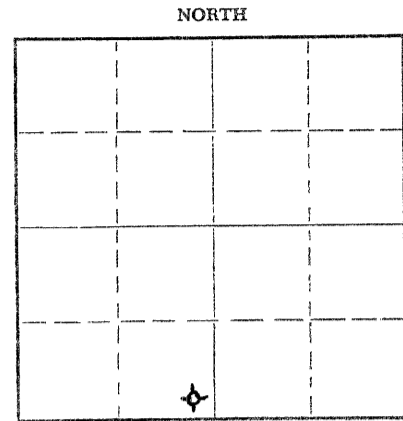

Locate well correctly on above Section Plat

Name of Conservation Agent who supervised plugging of this well Leo Massey, Hays, Kansas

Producing formation None Depth to top -- Bottom -- Total Depth of Well 3475 Feet

Show depth and thickness of all water, oil and gas formations.

OIL, GAS OR WATER RECORDS

CASING RECORD

FORMATION	CONTENT	FROM	TO	SIZE	PUT IN	PULLED OUT
				8-5/8"	248.87'	-0-

Describe in detail the manner in which the well was plugged, indicating where the mud fluid was placed and the method or methods used in introducing it into the hole. If cement or other plugs were used, state the character of same and depth placed, from feet to feet for each plug set.

Spotted 90 sacks 50-50 pozmix, 6% gel, at 680'.  
Mudded back to 240' and spotted 20 sacks pozmix,  
mudded back to 40', set solid bridge and capped with 8  
sacks, 2 sacks in rat hole.

RECEIVED  
STATE CORPORATION COMMISSION  
AUG 8 1967  
CONSERVATION DIVISION  
Wichita, Kansas  
8/8/67

(If additional description is necessary, use BACK of this sheet)

Name of Plugging Contractor Rains & Williamson Oil Co., Inc.

Address 1425 Wichita Plaza - Wichita, Kansas

STATE OF KANSAS, COUNTY OF SEDGWICK, ss.

Wilson Rains (employer or owner) or (owner or operator) of the above-described well, being first duly sworn on oath, says: That I have knowledge of the facts, statements, and matters herein contained and the log of the above-described well as filed and that the same are true and correct. So help me God.

(Signature) Wilson Rains

1425 Wichita Plaza - Wichita, Kansas

(Address)

SUBSCRIBED AND SWORN TO before me this 7th day of August, 19 67

My commission expires June 30, 1971

Sherry Gish Notary Public.

~~15-163-30272~~

ROTARY DRILLING LOG

15-163-20040-00-00

Operator: Rains & Williamson  
Oil Co., Inc.  
#1 GAGER  
SE SE SW Sec. 29-8S-16W  
Rooks County, Kansas

Contractor: Rains & Williamson  
Oil Co., Inc.  
Commenced: 7-24-67  
Completed: 8-2-67

Remarks: Set 8-5/8" surface  
casing at 248.87'  
w/150 sacks GL-3.

Formations

Surface Clay	40'
Post Rock & Shale	136'
Shale	1252'
Anhydrite	1294'
Shale	1745'
Lime and Shale	2525'
Shale	2725'
Shale and Lime	2886'
Lime and Shale	3040'
Lime	3475'
Rotary Total Depth (D & A)	3475'

RECEIVED  
STATE CORPORATION COMMISSION

AUG 8 1967

8/8/67


CONSERVATION DIVISION  
Wichita, Kansas

We certify the above log is  
true and correct to the best  
of our knowledge and belief.

RAINS & WILLIAMSON OIL CO., INC.

  
Wilson Rains

Subscribed and sworn to before me, a Notary Public within and for the State  
of Kansas, County of Sedgwick, this 7th day of August, 1967.

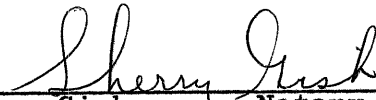  
Sherry Gish Notary Public

My Commission Expires:  
June 30, 1971