


WELL PLUGGING RECORD

Give All Information Completely
Make Required Affidavit
Mail or Deliver Report to:
Conservation Division
State Corporation Commission
211 No. Broadway
Wichita, Kansas

Rooks County, Sec. 31 Twp. 8S Rge. (E) 16 (W)

Location as "NE/CNW/SW" or footage from lines SW SW SW
Lease Owner Ryan Consolidated Petroleum Corp.
Lease Name Earl Boller Well No. 1
Office Address 3400 Republic National Bank Bldg., Dallas, Texas
Character of Well (completed as Oil, Gas or Dry Hole) Dry Hole
Date well completed November 29 19 62
Application for plugging filed November 29 19 62
Application for plugging approved November 29 19 62
Plugging commenced November 29 19 62
Plugging completed November 29 19 62
Reason for abandonment of well or producing formation Dry Hole

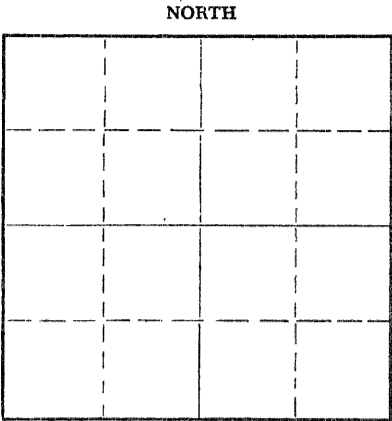

If a producing well is abandoned, date of last production 19
Was permission obtained from the Conservation Division or its agents before plugging was commenced? Yes

Name of Conservation Agent who supervised plugging of this well Eldon Petty
Producing formation Depth to top Bottom Total Depth of Well 3450 Feet
Show depth and thickness of all water, oil and gas formations.

OIL, GAS OR WATER RECORDS

CASING RECORD

FORMATION	CONTENT	FROM	TO	SIZE	PUT IN	PULLED OUT
Shale and Shells		0	177	8 5/8	177	none

Describe in detail the manner in which the well was plugged, indicating where the mud fluid was placed and the method or methods used in introducing it into the hole. If cement or other plugs were used, state the character of same and depth placed, from top feet to bottom feet for each plug set.

Set plug at 600 ft. with 20 sacks cement
hulls on top mud.
Set plug at 175 ft. with 20 sacks cement
hulls on top mud.
Set plug at 35 ft. with 10 sacks cement

RECEIVED
STATE CORPORATION COMMISSION

DEC 4 1962

CONSERVATION DIVISION
Wichita, Kansas

12/4/62

(If additional description is necessary, use BACK of this sheet)

Name of Plugging Contractor Bergman Drilling, Inc- 507
Address 425 Union Center Building, Wichita 2, Kansas

STATE OF Kansas, COUNTY OF Sedgwick, ss.
Harold Bergman (employee of owner) or (owner or operator) of the above-described well, being first duly sworn on oath, says: That I have knowledge of the facts, statements, and matters herein contained and the log of the above-described well as filed and that the same are true and correct. So help me God.

(Signature) Harold Bergman
425 Union Center Building, Wichita 2, Kansas
(Address)

SUBSCRIBED AND SWORN TO before me this 3rd day of December, 19 62

My commission expires August 2, 1966 Notary Public.



DRILLERS' LOG

Ryan Consolidated Petroleum Corporation
#1 Earl Boller - SW SW SW
Section 31-3S-16W
Rooks County, Kansas

15-163-19094-00-00

Date Commenced: November 19, 1962
Date Completed: November 29, 1962

Casing record:
8-5/8" set at 177 feet with 140 sacks cement.

0 - 177	Shale and Shells
177 - 675	Shale and Shells
675 - 750	Shale and Shells
750 - 940	Sakota Sand
940 - 1125	Red Bed and Shale
1125 - 1255	Red Bed and Shale
1255 - 1295	Anhydrite
1295 - 1360	Shale and Shells
1360 - 1645	Shale and Shells
1645 - 1810	Shale and Lime
1810 - 1960	Lime and Shale
1960 - 2095	Lime
2095 - 2200	Lime
2200 - 2310	Lime and Shale
2310 - 2440	Lime and Shale
2440 - 2580	Lime and Shale
2580 - 2710	Lime and Shale
2710 - 2820	Lime and Shale
2820 - 2935	Lime and Shale
2935 - 3015	Lime and Shale
3015 - 3055	Lime
3055 - 3125	Lime
3125 - 3185	Lime and Shale
3185 - 3200	Lime
3200 - 3255	Lime
3255 - 3298	Lime
3298 - 3330	Lime
3330 - 3340	Lime
3340 - 3400	Lime
3400 - 3450	Lime
3450	Rotary Total Depth

LOG TOPS:

Topeka	2840 (-886)
Heebner	3057 (-1103)
Toronto	3077 (-1123)
Lansing Kansas City	3098 (-1144)
Base Kansas City	3346 (-1392)
Arbuckle	3422 (-1468)
Log Total Depth	3442 (-1488)

RECEIVED
STATE CORPORATION COMMISSION

DEC 4 1962

CONSERVATION DIVISION
Wichita, Kansas

12/4/62

A F F I D A V I T

STATE OF KANSAS)
) SS.
COUNTY OF SEDGWICK)

I, Harold Beroman, do swear that the statements and matter herein contained are true to the best of my knowledge.

Harold Beroman

Subscribed and sworn to before me this 3rd day of December, 1962.

Dennis Jackson
Notary Public

My Commission Expires: August 2, 1966