


Give All Information Completely
Make Required Affidavit
Mail or Deliver Report to:
Conservation Division
State Corporation Commission
212 No. Market
Wichita, Kansas

WELL PLUGGING RECORD

Rooks County. Sec. 32 Twp. 8S Rge. 16 West (W)
Location as "NE/CNW/SW" or footage from lines SW SW SE
Lease Owner Tilco, et al
Lease Name Brown Well No. 1
Office Address 815 Wichita Plaza, Wichita, Kansas
Character of Well (completed as Oil, Gas or Dry Hole) Dry Hole
Date well completed 11-1 1968
Application for plugging filed 11-1 1968
Application for plugging approved 11-1 1968
Plugging commenced 11-1 1968
Plugging completed 11-1 1968
Reason for abandonment of well or producing formation Dry Hole

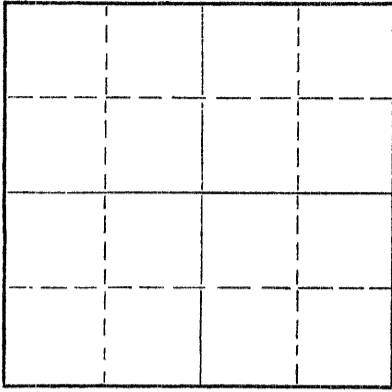

Locate well correctly on above Section Plat

If a producing well is abandoned, date of last production _____ 19____
Was permission obtained from the Conservation Division or its agents before plugging was commenced? Yes

Name of Conservation Agent who supervised plugging of this well Leo Massey
Producing formation _____ Depth to top _____ Bottom _____ Total Depth of Well 3330 Feet
Show depth and thickness of all water, oil and gas formations.

OIL, GAS OR WATER RECORDS

CASING RECORD

FORMATION	CONTENT	FROM	TO	SIZE	PUT IN	PULLED OUT
				8 5/8"	209'	none

Describe in detail the manner in which the well was plugged, indicating where the mud fluid was placed and the method or methods used in introducing it into the hole. If cement or other plugs were used, state the character of same and depth placed, from _____ feet to _____ feet for each plug set.

Plugged with 70 sacks 50/50 Posmix @ 540'
Plugged with 20 sacks 50/50 Posmix @ 180'
Plugged with 10 sacks 50/50 Posmix @ 40'

RECEIVED
STATE CORPORATION COMMISSION
NOV 12 1968
CONSERVATION DIVISION
Wichita, Kansas

11/12/68

(If additional description is necessary, use BACK of this sheet)

Name of Plugging Contractor Leben Drilling, Inc.
Address Box 496, Great Bend, Kansas

STATE OF KANSAS, COUNTY OF BARTON, ss.
Leslie Kite (employee of owner) or (owner or operator) of the above-described well, being first duly sworn on oath, says: That I have knowledge of the facts, statements, and matters herein contained and the log of the above-described well as filed and that the same are true and correct. So help me God.

(Signature) Leslie Kite

SUBSCRIBED AND SWORN TO before me this 8th day of November, 1968 (Address)

My commission expires April 1, 1971

Ulanda Nichols
Notary Public.
Ulanda Nichols

15-163-20146-00-00

DRILLER'S LOG

COMPANY	Tilco, et al
CONTRACTOR	LEBEN DRILLING, INC.
FARM	BROWN #1
LOCATION	SW SW SE SECTION 32-8S-16W ROOKS COUNTY, KANSAS
COMMENCED	10-26-68
COMPLETED	11-1-68

0	55	Post Rock
55	105	Shale, Sand
105	540	Shale
540	950	Sand
950	1236	Shale, Red Bed
1236	1274	Anhydrite
1274	1590	Shale
1590	1990	Shale, Lime
1990	2985	Lime, Shale
2985	3330	Lime
	<u>3330</u>	<u>RTD - D. & A.</u>

RECEIVED
STATE CORPORATION COMMISSION
NOV 12 1968
CONSERVATION DIVISION
Wichita, Kansas
11/12/68

8 5/8" 20# new surface casing set @ 209' cemented with 150 sacks
Common cement, 2% cc

I, Leslie Kite, do hereby certify that the above and foregoing is
a true and correct copy of the log of the Brown #1 Well, located
SW SW SE of Section 32, Township 8S, Range 16W, Rooks County, Kansas,
as reflected by the records of Leben Drilling, Inc.

Leslie Kite

Leslie Kite

STATE OF KANSAS)
) SS
COUNTY OF BARTON)

Subscribed and sworn to and before me, a Notary Public, in
and for Barton County, Kansas, this 8th day of November, 1968.

Ulanda Nichols

Ulanda Nichols

My Commission Expires:
April 1, 1971