


STATE OF KANSAS
STATE CORPORATION COMMISSION

15-163-19105-00-00

Give All Information Completely
Make Required Affidavit
Mail or Deliver Report to:
Conservation Division
State Corporation Commission
211 No. Broadway
Wichita, Kansas

WELL PLUGGING RECORD

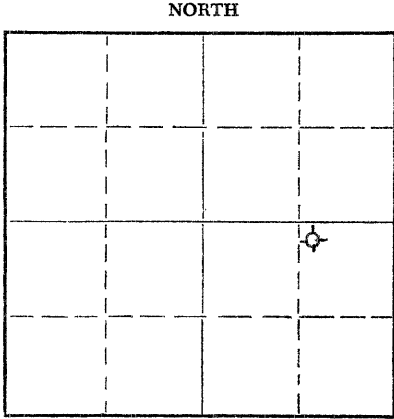

Locate well correctly on above Section Plat

Rooks County. Sec. 32 Twp. 8 Rge. 16 (E) W (W)
Location as "NE/CNW/SW" or footage from lines NW NE SE
Lease Owner C-G Drilling Co. & N. Appleman Co.
Lease Name Adams Well No. 1
Office Address 107 Rule Building, Wichita, Kansas
Character of Well (completed as Oil, Gas or Dry Hole) Dry Hole
Date well completed February 15, 19 57
Application for plugging filed February 15 19 57
Application for plugging approved February 15 19 57
Plugging commenced February 15 19 57
Plugging completed February 15 19 57
Reason for abandonment of well or producing formation Too low structurally

If a producing well is abandoned, date of last production 19
Was permission obtained from the Conservation Division or its agents before plugging was commenced? Yes

Name of Conservation Agent who supervised plugging of this well Eldon Petty, Hays, Kansas
Producing formation _____ Depth to top _____ Bottom _____ Total Depth of Well 3482' Feet
Show depth and thickness of all water, oil and gas formations.

OIL, GAS OR WATER RECORDS

CASING RECORD

FORMATION	CONTENT	FROM	TO	SIZE	PUT IN	PULLED OUT
				8-5/8"	220'	none

Describe in detail the manner in which the well was plugged, indicating where the mud fluid was placed and the method or methods used in introducing it into the hole. If cement or other plugs were used, state the character of same and depth placed, from _____ feet to _____ feet for each plug set.

Filled hole with heavy mud to 215'. Set plug. Put in 1/2 sack of Hulls & 15 sacks of Cement. Filled with heavy mud up to 40'. Set plug. Filled to top with 1/2 sack of Hulls & 10 sacks of cement.

(If additional description is necessary, use BACK of this sheet)

Name of Plugging Contractor C-G Drilling Co.
Address 107 Rule Building, Wichita, Kansas

STATE OF KANSAS, COUNTY OF SEDGWICK, ss.
Jay H. Galloway (employee of owner) or (owner or operator) of the above-described well, being first duly sworn on oath, says: That I have knowledge of the facts, statements, and matters herein contained and the log of the above-described well as filed and that the same are true and correct. So help me God.

(Signature) Jay H. Galloway
107 Rule Bldg.
(Address)

SUBSCRIBED AND SWORN to before me this 19th day of February, 19 57

My commission expires May 20, 1959

Vicky Jacobs
STATE CORPORATION COMMISSION Notary Public.

PLUGGING
SEC 32 T 8 R 16 W
BOOK PAGE 141 LI E. 33

FEB 20 1957 2/20/57
CONSERVATION DIVISION
WICHITA, KANSAS

15-103-19105-00-00

CONTRACTOR'S WELL LOG

OPERATOR C-G Drilling Co. & N. Appleman Co. WELL NAME Adams #1

LOCATION NW NE SE Sec. 32-8-16W RIG NO. 1

COUNTY Rooks STATE Kansas

COMMENCEMENT DATE February 5, 1957 COMPLETION DATE February 15, 1957

LOG OF WELL

Elevation 2008' rotary bushing.
 All measurements taken from the top of rotary bushing.

FROM	TO	FORMATION	DEVIATION FROM VERTICAL	REMARKS:
0	220	Surface Rock		
220	490	Shale		
490	545	Sand		
545	965	Sand-Shale		
965	1268	Red Bed		
1268	1303	Anhydrite		
1303	1800	Shale-Shells		
1800	1850	Shale-Shells		
1850	1985	Shale-Lime		
1985	2170	Shale-Lime		
2170	2340	Shale-Lime		
2340	2555	Shale-Lime	0° - 2500	
2555	2710	Shale-Lime		
2710	2907	Shale-Lime	0° - 2750	
2907	3075	Lime-Shale	0° - 3000	
3075	3208	Lime		
3208	3374	Lime	0° - 3250	
3374	3482	Lime		

CASING LEFT IN HOLE AFTER COMPLETION

Ran 221' (11 jts.) 8-5/8" OD Surface Casing.

STATE OF KANSAS }
 COUNTY OF SEDGWICK } ss.

The undersigned hereby certifies that to the best of his knowledge and belief, the above facts are true and correct.

C-G DRILLING CO.

By Jay H. Galloway
 Jay H. Galloway

Subscribed and sworn to before me this 19th day of February, 1957.

Vicky Jacobs
 Vicky Jacobs, Notary Public

My commission expires:
May 20, 1959

PLUGGING
 T. 32 N. 8 R. 16 W
 PAGE 141 LINE 33

2/20/57