

CARD MUST BE TYPED

State of Kansas
NOTICE OF INTENTION TO DRILL
(see rules on reverse side)

CARD MUST BE SIGNED

Starting Date: 3/14/85.....
month day year 10:30

API Number 15- 059-23,855-00-00

OPERATOR: License # 9607.....

NW/4 Sec 33.. Twp 15.. S, Rge 20.. East
(location) West

Name Max Painter.....

...3465..... Ft North from Southeast Corner of Section

Address 9865 Fairwood Lane.....

...3465..... Ft West from Southeast Corner of Section

City/State/Zip Memphis, TN 38119.....

(Note: Locate well on Section Plat on reverse side)

Contact Person Jim Mietchen.....

Phone 316-242-2700.....

Nearest lease or unit boundary line 825..... feet.

CONTRACTOR: License #

County Franklin.....

Name Unknown.....

Lease Name Pauline Scott..... Well# 25.....

City/State

Domestic well within 330 feet : yes no

Well Drilled For: Well Class: Type Equipment:

Oil Swd Infield Mud Rotary

Municipal well within one mile : yes no

Gas Inj Pool Ext. Air Rotary

Depth to Bottom of fresh water none..... feet

OWWO Expl Wildcat Cable

Lowest usable water formation

If OWWO: old well info as follows:

Depth to Bottom of usable water 200..... feet

Operator

Surface pipe by Alternate : 1 2

Well Name

Surface pipe to be set 40..... feet

Comp Date Old Total Depth

Conductor pipe if any required

Projected Total Depth 800..... feet

Ground surface elevation

Projected Formation at TD

This Authorization Expires 9-11-85.....

Expected Producing Formations

Approved By 3-11-85 *[Signature]*.....

I certify that we will comply with K.S.A. 55-101, et seq., plus eventually plugging hole to K.C.C. specifications.

3/11/85

Date Signature of Operator or Agent

Lisa Arnold

As Agent


WHC/NOHE 3-11-85

Wichita, Kansas
CONSERVATION DIVISION

MAR 1 1985

RECEIVED
STATE CORPORATION COMMISSION

A Regular Section of Land
1 Mile = 5,280 Ft.

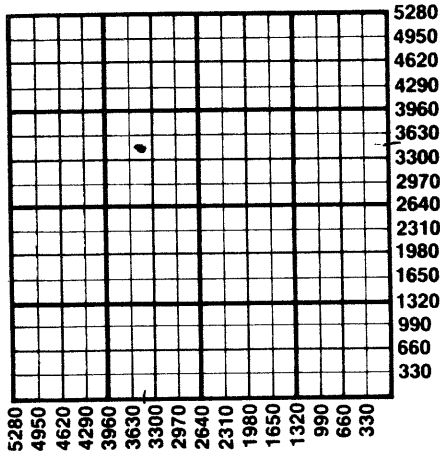

Must be filed with the K.C.C. five (5) days prior to commencing well
This card void if drilling not started within six (6) months of date received by K.C.C.

3-11-85

Important procedures to follow :

1. Notify District office before setting surface casing.
2. Set surface casing by circulating cement to the top.
3. File completion forms ACO-1 with K.C.C. within 90 days of well completion, following instructions on ACO-1, side 1, and including copies of wireline logs.
4. Notify District office 48 hours prior to old well workover or re-entry.
5. Prior to plugging, prepare a plugging plan, then obtain agreement from the appropriate district office for an approved plugging plan.
6. Submit plugging report (CP-4) to K.C.C. after plugging is completed.
7. Obtain an approved injection docket number before disposing of salt water.
8. Notify K.C.C. within 10 days when injection commences or terminates.
9. If an alternate 2 completion, cement in the production pipe from below any usable water to surface within 120 days of spud date.

State Corporation Commission of Kansas
Conservation Division
200 Colorado Derby Building
Wichita, Kansas 67202
(316) 263-3238